

CARD MUST BE TYPED

State of Kansas

CARD MUST BE SIGNED

NOTICE OF INTENTION TO DRILL

(see rules on reverse side)

Starting Date 11 2 85
month day year 11/10

API Number 15- 121-26, 698-00-00

OPERATOR: License # 4509 App.

NW SE SE Sec. 33. Twp. 16... S, Rg. 23.... X East
..... West

Name Nor-Con Oil Co
Address 9704 Richmond Dr.

..... 775 Ft. from South Line of Section
..... 975 Ft. from East Line of Section

City/State/Zip Kansas City, Mo. 64134

(Note: Locate well on Section Plat on reverse side)

Contact Person John R. Norris

Phone (816) 761-2053

Nearest lease or unit boundary line ... 675 feet

CONTRACTOR: License # 8469

County Miami

Name Nickell Drilling

Lease Name Ray Edwards Well # 1

City/State Rt. 1, Parker KS 66072

Ground surface elevation n/a feet MSL

Well Drilled For: Well Class: Type Equipment:

Domestic well within 330 feet: — yes X no

X Oil — SWD X Infield X Mud Rotary

Municipal well within one mile: — yes X no

— Gas — Inj — Pool Ext. — Air Rotary

Surface pipe by Alternate: 1 — 2 X

— OWWO — Expl — Wildcat — Cable

Depth to bottom of fresh water ... 80 feet

If OWWO: old well info as follows:

Depth to bottom of usable water ... 200 feet

Operator

Surface pipe planned to be set ... 20 feet

Well Name

Projected Total Depth ... 350 feet

Comp Date Old Total Depth

Formation Peru

I certify that well will comply with K.S.A. 55-101, et seq., plus eventually plugging hole to KCC specifications.

_____ cementing will be done immediately upon setting production casing.

Date Oct. 31, 1985.. Signature of Operator or Agent *Kenneth Bigelow* Title AS agent

For KCC Use:

Conductor Pipe Required feet; Minimum Surface Pipe Required feet per Alt. 2

This Authorization Expires *5-1-86* Approved By *10-31-85* *R*

Must be filed with the K.C.C. five (5) days prior to commencing well
 This card void if drilling not started within six (6) months of date received by K.C.C.

Important procedures to follow:


RECEIVED
 STATE CORPORATION COMMISSION

1. Notify District office before setting surface casing.

A Regular Section of Land

1 Mile = 5,280 Ft.

OCT 31 1985

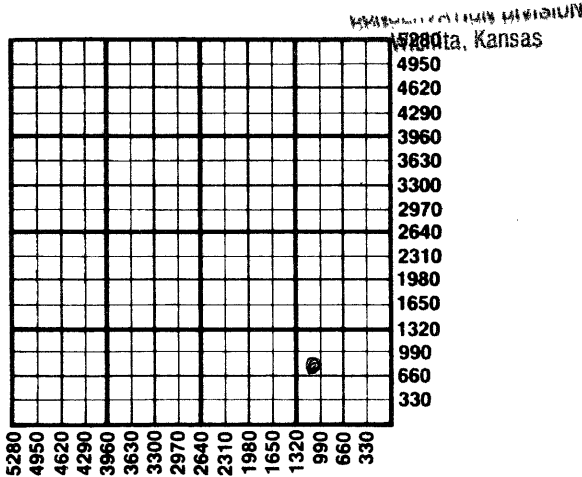

2. Set surface casing by circulating cement to the top.
3. File completion forms ACO-1 with K.C.C. within 90 days of well completion, following instructions on ACO-1, side 1, and including copies of wireline logs.
4. Notify District office 48 hours prior to old well workover or re-entry.
5. Prior to filing Intent, prepare a proposed plugging plan in case well is D & A, then obtain approval of plan when calling district office prior to setting surface pipe.
6. Submit plugging report (CP-4) to K.C.C. after plugging is completed.
7. Obtain an approved injection docket number before disposing of salt water.
8. Notify K.C.C. within 10 days when injection commences or terminates.
9. If an alternate 2 completion, cement in the production pipe from below any usable water to surface within 120 days of spud date.

State Corporation Commission of Kansas
 Conservation Division
 200 Colorado Derby Building
 Wichita, Kansas 67202
 (316) 263-3238