

Effective Date: 12-22-01
District # 4
SGA? Yes No

KANSAS CORPORATION COMMISSION
OIL & GAS CONSERVATION DIVISION
NOTICE OF INTENT TO DRILL

Form C-1
September 1999
Form must be Typed
Form must be Signed
All blanks must be Filled

Must be approved by KCC five (5) days prior to commencing well

Expected Spud Date 12 18 01
month day year

Spot NE NE NW East
370 - 2127 feet from N (circle one) Line of Section
2127 feet from W (circle one) Line of Section
Is SECTION Regular Irregular?

OPERATOR: License# 30076
Name: A & A PRODUCTION
Address: PO BOX 100
City/State/Zip: HILL CITY KS 67642
Contact Person: ANDY ANDERSON
Phone: 785-421-6266

CONTRACTOR: License# 30076
Name: A & A PRODUCTION

Well Drilled For: Oil Gas OWD Seismic; # of Holes Other
Well Class: Enh Rec Storage Disposal Infield Pool Ext Wildcat Other
Type Equipment: Mud Rotary Air Rotary Cable

(Note: Locate well on the Section Plat on reverse side)
County: ROCKS
Lease Name: MELTON Well #: 1
Field Name: _____
Is this a Prorated / Spaced Field? Yes No
Target Information(s): ARBUCKLE
Nearest Lease or unit boundary: 370
Ground Surface Elevation: 1933 feet MSL
Water well within one-quarter mile: Yes No
Public water supply well within one mile: Yes No
Depth to bottom of fresh water: 200
Depth to bottom of usable water: 200-780
Surface Pipe by Alternate: 1 2
Length of Surface Pipe Planned to be set: 1200
* Length of Conductor Pipe required: none
Projected Total Depth: 3800
Producing Formation Target: ARBUCKLE
Water Source for Drilling Operations: Well _____ Farm Pond _____ Other: xx
DWR Permit #: _____
(Note: Apply for Permit with DWR)
Will Cores be taken? Yes No
If Yes, proposed zone: _____

If OWWO: old well information as follows:

Operator: _____
Well Name: _____
Original Completion Date: _____ Original Total Depth: _____

Directional, Deviated or Horizontal wellbore? Yes No

If Yes, true vertical depth: _____

Bottom Hole Location: _____

KCC DKT #: _____

RECEIVED

DEC 17 2001

KCC WICHITA

AFFIDAVIT * NOTE WITHIN AREA OF SHALLOW FLOWS!
FOR AREAS BELOW 1860 G.L.

The undersigned hereby affirms that the drilling, completion and eventual plugging of this well will comply with K.S.A. 55-101, et. seq.
It is agreed that the following minimum requirements will be met:

1. Notify the appropriate district office prior to spudding of well;
2. A copy of the approved notice of intent to drill shall be posted on each drilling rig;
3. The minimum amount of surface pipe as specified below shall be set by circulating cement to the top; in all cases surface pipe shall be set through all unconsolidated materials plus a minimum of 20 feet into the underlying formation.
4. If the well is dry hole, an agreement between the operator and the district office on plug length and placement is necessary prior to plugging;
5. The appropriate district office will be notified before well is either plugged or production casing is cemented in;
6. If an ALTERNATE II COMPLETION, production pipe shall be cemented from below any usable water to surface within 120 days of spud date. In all cases, NOTIFY district office prior to any cementing.

I hereby certify that the statements made herein are true and to the best of my knowledge and belief.

Date: 12-14-01 Signature of Operator or Agent: Andy Anderson Title: CONTRACTOR

For KCC Use ONLY

API # 15 - 163-23343-0000

Conductor pipe required NONE feet

Minimum surface pipe required 800 feet per Alt. 1

Approved by: RJP 12-17-01

This authorization expires: 6-17-02

(This authorization void if drilling not started within 6 months of effective date.)

Spud date: _____ Agent: _____

Remember to:

- File Drill Pit Application (form CDP-1) with Intent to Drill;
- File Completion Form ACO-1 within 120 days of spud date;
- File acreage attribution plat according to field proration orders;
- Notify appropriate district office 48 hours prior to workover or re-entry;
- Submit plugging report (CP-4) after plugging is completed;
- Obtain written approval before disposing or injecting salt water.

2
7
173

IN ALL CASES PLOT THE INTENDED WELL ON THE PLAT BELOW

Plat of acreage attributable to a well in a prorated or spaced field

If the intended well is in a prorated or spaced field, please fully complete this side of the form. If the intended well is in a prorated or spaced field complete the plat below showing that the well will be properly located in relationship to other wells producing from the common source of supply. Please show all the wells and within 1 mile of the boundaries of the proposed acreage attribution unit for gas wells and within 1/2 mile of the boundaries of the proposed acreage attribution unit for oil wells.

API No. 15 - _____

Operator: A & A PRODUCTION

Lease: MELTON

Well Number: 1

Field: _____

Number of Acres attributable to well: 10

QTR / QTR / QTR of acreage: NE - NE - NW

Location of Well: County: ROOKS

370 feet from S N (circle one) Line or Section

2127 feet from E W (circle one) Line of Section

Sec. 2 Twp. 7 S. R. 17 East West

Is Section X Regular or _____ Irregular



If Section is Irregular, locate well from nearest corner boundary.

Section corner used: NE NW SE SW

PLAT

(Show location of the well and shade attributable acreage for prorated or spaced wells.)

(Show footage to the nearest lease or unit boundary line.)

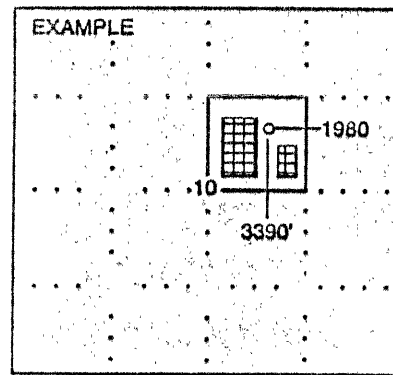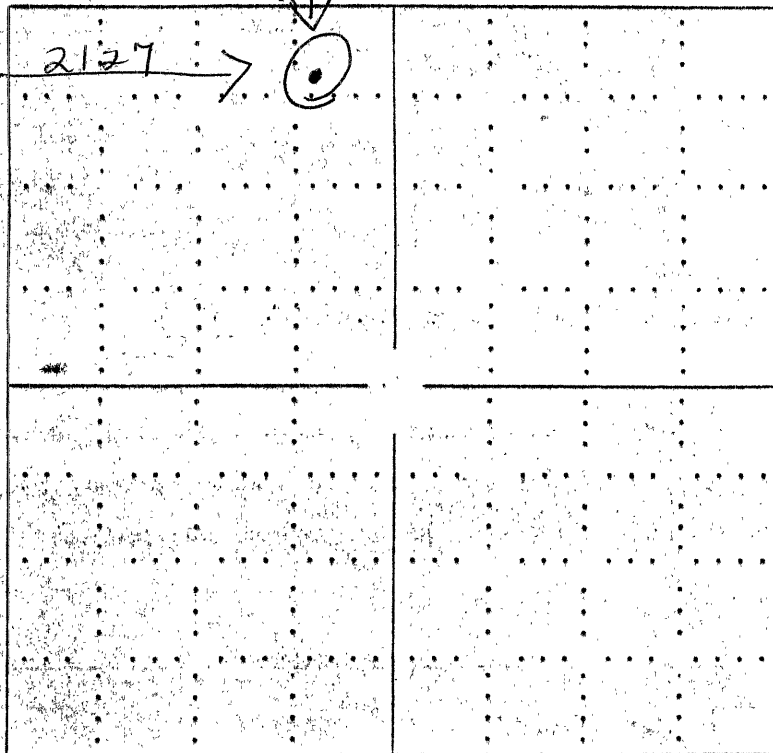

SEWARD CO.

NOTE: In all cases locate the spot of the proposed drilling location.

In plotting the proposed location of the well, you must show:

1. The manner in which you are using the depicted plat by identifying section lines, i.e. 1 section, 1 section with 8 surrounding sections, 4 sections, etc.
2. The distance of the proposed drilling location from the section's south / north and east / west.
3. The distance to the nearest lease or unit boundary line.
4. If proposed location is located within a prorated or spaced field a certificate of acreage attribution plat must be attached: (CO-7 for oil wells; CG-8 for gas wells).