


STATE OF KANSAS
STATE CORPORATION COMMISSION

15-181-20200-0000

WELL PLUGGING RECORD

Give All Information Completely
Make Required Affidavit
Mail or Deliver Report to
Conservation Division
State Corporation Comm.
245 North Water
Wichita, KS 67202

Sherman County, Sec. 18 Twp. 6S Rge. 40 W E
Location as "NE/CNW $\frac{1}{4}$ SW $\frac{1}{4}$ " or footage from lines
C SW/4 SE/4
Lease Owner Shepler & Thomas, Inc.
Lease Name Edwards Well No. 1.
Office Address P.O. Box 2164 Evergreen, Co. 80439
Character of Well (Completed as Oil, Gas or Dry Hole)
Dry Hole - Rotary
Date Well completed 12-12 19
Application for plugging filed verbal 12-12 19
Application for plugging approved same 19
Plugging commenced same 19
Plugging completed same 19
Reason for abandonment of well or producing formation
Dry Hole
If a producing well is abandoned, date of last production 19.

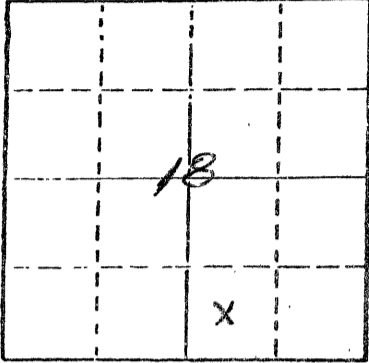

Locate well correctly on above
Section Plat

Was permission obtained from the Conservation Division or
its agents before plugging was commenced? yes

Name of Conservation Agent who supervised plugging of this well Gilbert Bacthazor
Producing formation Niobrara Depth to top 1560 Bottom 1590 Total Depth of Well 1688
Show depth and thickness of all water, oil and gas formations.

OIL, GAS OR WATER RECORDS

CASING RECORD

FORMATION	CONTENT	FROM	TO	SIZE	PUT IN	PULLED OUT
Niobrara	water	1560	1590	7"	356'	none

Describe in detail the manner in which the well was plugged, indicating where the mud fluid
was placed and the method or methods used in introducing it into the hold. If cement or other
plugs were used, state the character of same and depth placed, from _____ feet to
_____ feet for each plug set.

- 40 sx 200' 1550-1350'
- 30 sx 145' 400'-350'
- 10 sx at 40' on solid rubber plug

(If additional description is necessary, use BACK of this sheet)

Name of Plugging Contractor Western Well Drilling FEB - 4 1981 2-4-81

STATE OF Colorado COUNTY OF Jefferson
Allen Thomas (employee of owner) or (owner or operator)

of the above-described well, being first duly sworn on oath, says: That I have knowledge of
the facts, statements, and matters herein contained and the log of the above-described well
as filed and that the same are true and correct. So help me God.

(Signature) Allen Thomas

SUBSCRIBED AND SWORN TO before me this 2nd day of February, 1981

(Address)
Genevieve S. Cavanaugh
Notary Public.

My commission expires 9-9-84