


STATE OF KANSAS
STATE CORPORATION COMMISSION

Give All Information Completely
Make Required Affidavit
Mail or Deliver Report to:
Conservation Division
State Corporation Commission
211 No. Broadway
Wichita, Kansas

13-181-00005-00-00

WELL PLUGGING RECORD

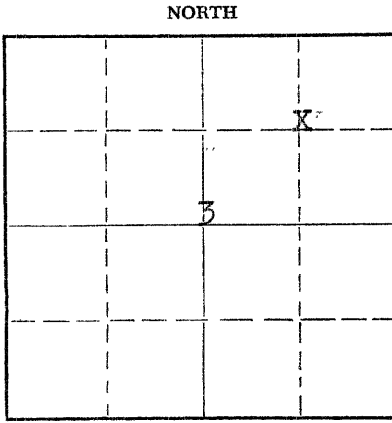

Locate well correctly on above Section Plat

Sherman County, Sec. 3 Twp. 6S Rge. 40 (W)
Location as "NE/CNW/SW" or footage from lines NE 1/4 NE 1/4
Lease Owner R. G. Lawton
Lease Name Emil Peter Well No. #1
Office Address Box 620, Magnolia, Arkansas
Character of Well (completed as Oil, Gas or Dry Hole) Dry Hole
Date well completed August 17 19 58
Application for plugging filed August 17 19 58
Application for plugging approved August 17 19 58
Plugging commenced August 17 19 58
Plugging completed August 17 19 58
Reason for abandonment of well or producing formation Dry hole

If a producing well is abandoned, date of last production 19
Was permission obtained from the Conservation Division or its agents before plugging was commenced? Yes

Name of Conservation Agent who supervised plugging of this well Fadricius
Producing formation Depth to top Bottom Total Depth of Well 5500' Feet
Show depth and thickness of all water, oil and gas formations.

OIL, GAS OR WATER RECORDS

CASING RECORD

FORMATION	CONTENT	FROM	TO	SIZE	PUT IN	PULLED OUT

Describe in detail the manner in which the well was plugged, indicating where the mud fluid was placed and the method or methods used in introducing it into the hole. If cement or other plugs were used, state the character of same and depth placed, from feet to feet for each plug set.

Cement Plugs (1) 25 Sacks - 600' - 540'
(2) 15 Sacks - 250' - 220'
(3) 10 Sacks - 20' - 0'

(If additional description is necessary, use BACK of this sheet)

Name of Plugging Contractor Halliburton Oil Well Cementing Company
Address Hays, Kansas

STATE OF Arkansas COUNTY OF Columbia, ss.
J. R. McLaughlin (employee of owner) or (~~OWNER OR OPERATOR~~) of the above-described well, being first duly sworn on oath, says: That I have knowledge of the facts, statements, and matters herein contained and the log of the above-described well as filed and that the same are true and correct. So help me God.

(Signature) J. R. McLaughlin
c/o R.G. Lawton, Box 620, Magnolia, Arkansas
(Address)

SUBSCRIBED AND SWORN TO before me this 25 day of August 19 58

My commission expires July 22, 1962

Roland R. Toevs
Roland R. Toevs Notary Public.

STATE OF KANSAS
AUG 22 1958
CONSERVATION DIVISION
Wichita, Kansas

AUG 27 1958
8-27-58
PLUGGING CONSERVATION DIVISION
FILE SEC 3 T 6 R 40W
BOOK PAGE 123 LINE 45
Wichita, Kansas