


15-141-00029-00-00

STATE OF KANSAS
STATE CORPORATION COMMISSION

Give All Information Completely
Make Required Affidavit
Mail or Deliver Report to:
Conservation Division
State Corporation Commission
800 Bitting Building
Wichita, Kansas

WELL PLUGGING RECORD

NORTH

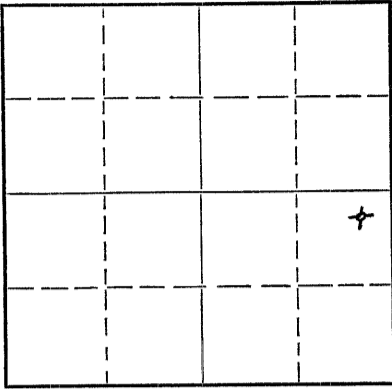

Locate well correctly on above
Section Plat

Osborne County. Sec. 32 Twp. 7S Rge. 15 (E) W(W)
Location as "NE/CNW $\frac{1}{4}$ SW $\frac{1}{4}$ " or footage from lines NE NE Se
Lease Owner Anderson-Prichard Oil Corp.
Lease Name Stephenson Well No. 1
Office Address Liberty Bank Building, Oklahoma City, Oklahoma
Character of Well (completed as Oil, Gas or Dry Hole) Dry Hole
Date well completed Nov. 16 1952
Application for plugging filed Nov. 16 1952
Application for plugging approved Nov. 16 1952
Plugging commenced Nov. 16 1952
Plugging completed Nov. 16 1952
Reason for abandonment of well or producing formation Dry Hole

If a producing well is abandoned, date of last production 19...
Was permission obtained from the Conservation Division or its agents before plugging was commenced? Yes

Name of Conservation Agent who supervised plugging of this well C. D. Stough
Producing formation Depth to top Bottom Total Depth of Well 3723 Feet
Show depth and thickness of all water, oil and gas formations.


OIL, GAS OR WATER RECORDS

CASING RECORD

Formation	Content	From	To	Size	Put In	Pulled Out
		0	195'	8 5/8"	195	None

Describe in detail the manner in which the well was plugged, indicating where the mud fluid was placed and the method or methods used in introducing it into the hole. If cement or other plugs were used, state the character of same and depth placed, from... feet to ... feet for each plug set.

3723' - 186 $\frac{1}{2}$ ' - Rotary Mud
186 $\frac{1}{2}$ ' - 185' - Wooden Plug
185' - 139' - 15 sacks cement
139' - 41 $\frac{1}{2}$ ' - Rotary Mud
41 $\frac{1}{2}$ ' - 40' - Wooden Plug
40' - 6' - 10 sacks cement
6' - Surface - Cellar

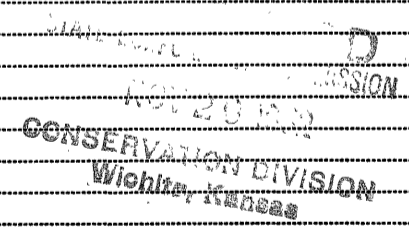

11-20-52

(If additional description is necessary, use BACK of this sheet)
Name of Plugging Contractor Glenn W. Peel
Address P. O. Box 359, Hoisington, Kansas

STATE OF Kansas, COUNTY OF Barton, ss.
Glenn W. Peel (employee of owner) or (owner or operator) of the above-described well,
being first duly sworn on oath, says: That I have knowledge of the facts, statements, and matters herein contained and the log of the above-described well as filed and that the same are true and correct. So help me God.

(Signature) BY: Glenn W. Peel
P. O. Box 359
Hoisington, Kansas (Address)

SUBSCRIBED AND SWORN TO before me this 17th day of November, 1952

Marion M. Herbst
Notary Public.

My commission expires June 4, 1955

23-8390-s 6-51-20M

