


Give All Information Completely
Make Required Affidavit
Mail or Deliver Report to:
Conservation Division
State Corporation Commission
800 Bitting Building
Wichita, Kansas

WELL PLUGGING RECORD

NORTH

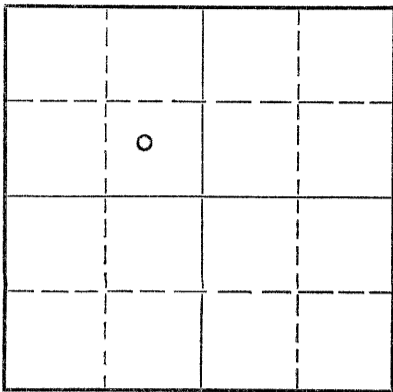

Locate well correctly on above
Section Plat

Sherman County. Sec. 33 Twp. 6S Rge. 41W (E) W (W)
Location as "NE/CNW/SW" or footage from lines C SE/4 - NW/4
Lease Owner Curt Brown Drilling Company Norbla Oil Co.
Lease Name Euwer Well No. 1
Office Address 516 Mayo Building, Tulsa 3, Oklahoma
Character of Well (completed as Oil, Gas or Dry Hole) dry
Date well completed Oct 28th 19 59
Application for plugging filed ditto 19
Application for plugging approved " 19
Plugging commenced " 19
Plugging completed " 19
Reason for abandonment of well or producing formation dry hole

If a producing well is abandoned, date of last production _____ 19____
Was permission obtained from the Conservation Division or its agents before plugging was commenced? yes

Name of Conservation Agent who supervised plugging of this well Mr. Fabricus
Producing formation _____ Depth to top _____ Bottom _____ Total Depth of Well 5442 Feet
Show depth and thickness of all water, oil and gas formations.

OIL, GAS OR WATER RECORDS

CASING RECORD

FORMATION	CONTENT	FROM	TO	SIZE	PUT IN	PULLED OUT
				8-5/8	279.66'	none

Describe in detail the manner in which the well was plugged, indicating where the mud fluid was placed and the method or methods used in introducing it into the hole. If cement or other plugs were used, state the character of same and depth placed, from _____ feet to _____ feet for each plug set.

Pumped hole full to top with heavy rotary mud and spotted
20 sacks cement 550 foot level
20 " " 250 " "
10 " " 40 " " to top of surface pipe
which is two feet below ground level

RECEIVED
STATE CORPORATION COMMISSION

NOV 6 1959

CONSERVATION DIVISION
Wichita, Kansas

(If additional description is necessary, use BACK of this sheet)
Name of Plugging Contractor Curt Brown Drilling Company
Address 516 Mayo Building, Tulsa 3, Oklahoma

STATE OF Oklahoma, COUNTY OF Tulsa, ss.
owner

(employee of owner) or (owner or operator) of the above-described well, being first duly sworn on oath, says: That I have knowledge of the facts, statements, and matters herein contained and the log of the above-described well as filed and that the same are true and correct. So help me God.

(Signature) Curt Brown
516 Mayo Bldg, Tulsa 3, Oklahoma
(Address)

SUBSCRIBED AND SWORN TO before me this 2nd day of November, 19 59

My commission expires 8/12/62

Lloyd S. Miller
Notary Public.