


15-181-00023-00-00

Give All Information Completely  
Make Required Affidavit  
Mail or Deliver Report to:  
Conservation Division  
State Corporation Commission  
212 North Market, Insurance Bldg.  
Wichita, Kansas

WELL PLUGGING RECORD

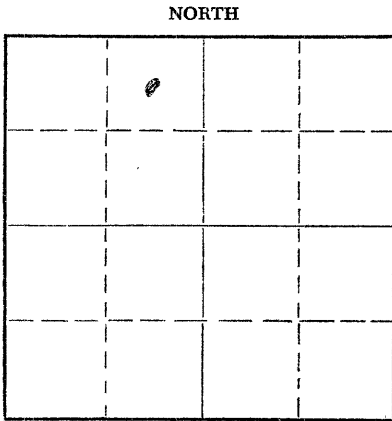

Locate well correctly on above Section Plat

Sherman County. Sec. 22 Twp. 6-S Rge. 41 (X) W (W)  
Location as "NE/CNW $\frac{1}{4}$ SW $\frac{1}{4}$ " or footage from lines C of NE/4-NW/4  
Lease Owner Curt Brown Drilling Company Norbla Oil Co.  
Lease Name Defries Well No. 1  
Office Address 516 Mayo Building Tulsa 3, Oklahoma  
Character of Well (completed as Oil, Gas or Dry Hole) Dry  
Date well completed October 3rd 19 59  
Application for plugging filed October 3rd 19 59  
Application for plugging approved October 3rd 19 59  
Plugging commenced October 3rd 19 59  
Plugging completed October 3rd 19 59  
Reason for abandonment of well or producing formation dry hole

If a producing well is abandoned, date of last production \_\_\_\_\_ 19\_\_\_\_  
Was permission obtained from the Conservation Division or its agents before plugging was commenced? Yes

Name of Conservation Agent who supervised plugging of this well Mr. Fabricus  
Producing formation \_\_\_\_\_ Depth to top \_\_\_\_\_ Bottom \_\_\_\_\_ Total Depth of Well 5400 Feet  
Show depth and thickness of all water, oil and gas formations.

OIL, GAS OR WATER RECORDS

CASING RECORD

FORMATION	CONTENT	FROM	TO	SIZE	PUT IN	PULLED OUT
				8-5/8"	263'	None

Describe in detail the manner in which the well was plugged, indicating where the mud fluid was placed and the method or methods used in introducing it into the hole. If cement or other plugs were used, state the character of same and depth placed, from \_\_\_\_\_ feet to \_\_\_\_\_ feet for each plug set.

Pumped hole full to top with heavy drilling mud and  
20 saks cement at the 600 foot level  
20 saks cement at the 250 foot level and  
10 saks cement at the 30 foot level to top of surface  
pipe which is two feet below ground level.

**RECEIVED**  
STATE CORPORATION COMMISSION  
OCT 13 1959 10-13-59  
CONSERVATION DIVISION  
Wichita, Kansas

(If additional description is necessary, use BACK of this sheet)  
Name of Plugging Contractor Curt Brown Drilling Company  
Address 516 Mayo Building Tulsa, Oklahoma

STATE OF Oklahoma, COUNTY OF Tulsa, ss.  
Owner \_\_\_\_\_ (employee of owner) or (owner or operator) of the above-described well, being first duly sworn on oath, says: That I have knowledge of the facts, statements, and matters herein contained and the log of the above-described well as filed and that the same are true and correct. So help me God.

(Signature) Curt Brown  
516 Mayo Bldg., Tulsa, Oklahoma  
(Address)

SUBSCRIBED AND SWORN TO before me this 7th day of October, 19 59  
My commission expires August 12, 1962  
Lloyd S. Miller  
Notary Public.

