

15-181-20201-0000

STATE OF KANSAS
STATE CORPORATION COMMISSION

WELL PLUGGING RECORD

Give All Information Completely
Make Required Affidavit
Mail or Deliver Report to
Conservation Division
State Corporation Comm.
245 North Water
Wichita, KS 67202

Sherman County, Sec. 21 Twp. 6S Rge. 41W E/W
Location as "NE/CNW $\frac{1}{4}$ SW $\frac{1}{4}$ " or footage from lines
C SW SW

Lease Owner Shepler & Thomas - Anador Resources
Lease Name Schlepp Well No. 1

Office Address P.O. Box 2164 Evergreen, Co. 80439
Character of Well (Completed as Oil, Gas or Dry Hole)

Dry Hole

Date Well completed January 6 1981

Application for plugging filed January 6 1981

Application for plugging approved verbal ok 19


Plugging commenced January 6 1981

Plugging completed January 6 1981

Reason for abandonment of well or producing formation
Dry Hole

If a producing well is abandoned, date of last production
19.

Was permission obtained from the Conservation Division or
its agents before plugging was commenced?

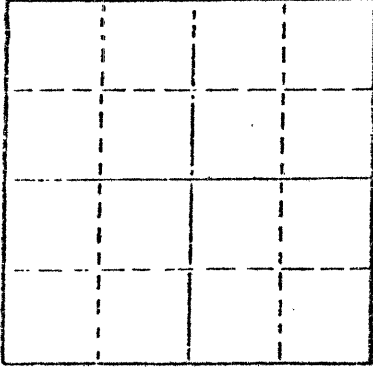

Locate well correctly on above
Section Plat

Name of Conservation Agent who supervised plugging of this well Gilbert Balthazor
Producing formation _____ Depth to top _____ Bottom _____ Total Depth of Well 1565
Show depth and thickness of all water, oil and gas formations.

OIL, GAS OR WATER RECORDS

CASING RECORD

FORMATION	CONTENT	FROM	TO	SIZE	PUT IN	PULLED OUT
Niobrara	water	1450	1490	7"	329	None

Describe in detail the manner in which the well was plugged, indicating where the mud fluid
was placed and the method or methods used in introducing it into the hold. If cement or other
plugs were used, state the character of same and depth placed, from _____ feet to
_____ feet for each plug set.

40 sx at 1560'

30 sx at 300'

10 sx at 40' on solid plug - Rubber & Halls

(If additional description is necessary, use BACK of this sheet)

Name of Plugging Contractor Sun Oil Well Cementing

STATE OF Colorado COUNTY OF Jefferson, ss.
Allen N. Thomas (employee of owner) or (owner or operator)

of the above-described well, being first duly sworn on oath, says: That I have knowledge of
the facts, statements, and matters herein contained and the log of the above-described well
as filed and that the same are true and correct. So help me God.

(Signature)

Allen N. Thomas
Box 2164 Evergreen Co. 80439
(Address)

SUBSCRIBED AND SWORN TO before me this 12 day of March, 1981

Genevieve S. Cavanaugh
Notary Public

My commission expires 9-9-84

Rec'd
3-13-81