

15-123-00008-00-00

STATE OF KANSAS
STATE CORPORATION COMMISSION

WELL PLUGGING RECORD

Give All Information Completely
Make Required Affidavit
Mail or Deliver Report to:
Conservation Division
State Corporation Commission
800 Biting Building
Wichita, Kansas

Mitchell

County. Sec. 7 Twp. 7S. Rge. 7W (E) (W)

Location as "NE/CNW $\frac{1}{4}$ SW $\frac{1}{4}$ " or footage from lines SW SW $\frac{1}{2}$

Lease Owner A. D. Allison & Co., et al

Lease Name Van Pelt

Well No. 1

Office Address 715 Brown Building, Wichita, Kansas

Character of Well (completed as Oil, Gas or Dry Hole) Dry hole

Date well completed 10-25 1950

Application for plugging filed " 19

Application for plugging approved " 19


Plugging commenced " 19

Plugging completed " 19

Reason for abandonment of well or producing formation Dry hole

If a producing well is abandoned, date of last production 19

Was permission obtained from the Conservation Division or its agents before plugging was commenced? Yes

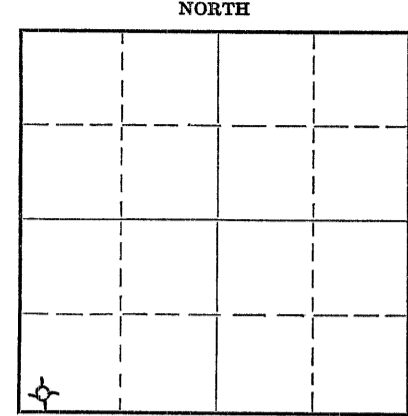

Locate well correctly on above Section Plat

Name of Conservation Agent who supervised plugging of this well Ruel Durkee

Producing formation Depth to top Bottom Total Depth of Well 3948 Feet

Show depth and thickness of all water, oil and gas formations.

OIL, GAS OR WATER RECORDS

CASING RECORD

Formation	Content	From	To	Size	Put In	Pulled Out
Sand	Water	16	58			
Sand	"	250	360			
Sand	"	412	417	8-5/8	460	None

Describe in detail the manner in which the well was plugged, indicating where the mud fluid was placed and the method or methods used in introducing it into the hole. If cement or other plugs were used, state the character of same and depth placed, from feet to feet for each plug set.

Bottom plug set at 220'. Mixed and poured 25 sacks cement through drill pipe. Filled hole with mud and set top plug at 15' with 15 sacks cement on top of plug to surface.

RECEIVED
STATE CORPORATION COMMISSION
OCT 28 1950
CONSERVATION DIVISION
Wichita, Kansas

(If additional description is necessary, use BACK of this sheet)

Correspondence regarding this well should be addressed to A. D. Allison & Co., Inc., 1028-50
Address 715 Brown Building, Wichita 2, Kansas.

STATE OF Kansas, COUNTY OF Sedgwick, ss.
J. A. Allison

(employee of owner) or (owner or operator) of the above-described well, being first duly sworn on oath, says: That I have knowledge of the facts, statements, and matters herein contained and the log of the above-described well as filed and that the same are true and correct. So help me God.

(Signature)

715 Brown Building, Wichita, Kansas.
(Address)

SUBSCRIBED AND SWORN to before me this 26th day of October, 1950

My commission expires 7-22-53

Notary Public

28-3273-s 4-50-10M

PLUGGING
FILE SEC 7 T 7 R 7 W
BOOK PAGE 39 LINE 14