

15-163-20499-00-00


STATE OF KANSAS
STATE CORPORATION COMMISSION

Form CP-4

Give All Information Completely
Make Required Affidavit
Mail or Deliver Report to:
Conservation Division
State Corporation Commission

WELL PLUGGING RECORD

P. O. Box 17027
Wichita, Kansas 67217
NORTH

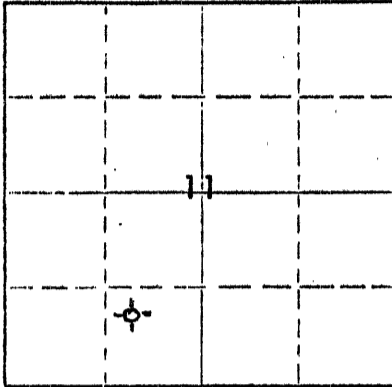

Locate well correctly on above
Section Plat

ROOKS County, Sec. 11 Twp. 7S Rge. 17 (E) 17 (W)
Location as "NE/CNW/SE/SW" or footage from lines NW SE SW
Lease Owner T E ANDERSON
Lease Name SIMONS Well No. 4
Office Address 710 UNION NATIONAL BLDG, WICHITA, KANSAS 67202
Character of Well (completed as Oil, Gas or Dry Hole) DRY HOLE
Date well completed AUGUST 11 1973
Application for plugging filed AUGUST 11 1973
Application for plugging approved AUGUST 11 1973
Plugging commenced AUGUST 11 1973
Plugging completed AUGUST 11 1973
Reason for abandonment of well or producing formation TOO LOW STRUCTURALLY

If a producing well is abandoned, date of last production _____ 19____
Was permission obtained from the Conservation Division or its agents before plugging was commenced? YES

Name of Conservation Agent who supervised plugging of this well LEO F MASSEY, HAYS, KANSAS
Producing formation _____ Depth to top _____ Bottom _____ Total Depth of Well 3260' Feet
Show depth and thickness of all water, oil and gas formations.

OIL, GAS OR WATER RECORDS

CASING RECORD

FORMATION	CONTENT	FROM	TO	SIZE	PUT IN	PULLED OUT
				8 5/8"	1239.11'	NONE

Describe in detail the manner in which the well was plugged, indicating where the mud fluid was placed and the method or methods used in introducing it into the hole. If cement or other plugs were used, state the character of same and depth placed, from _____ feet to _____ feet for each plug set.

FILLED WITH HEAVY MUD TO 400'. SET PLUG. PUT IN 25 SACKS CEMENT. FILLED WITH HEAVY MUD TO 40'. SET PLUG. FILLED TO TOP WITH 10 SACKS CEMENT.

RECEIVED
STATE CORPORATION COMMISSION
JAN 4 1974
CONSERVATION DIVISION
Wichita, Kansas

(If additional description is necessary, use BACK of this sheet)
Name of Plugging Contractor C-G DRILLING CO.
Address 1107 UNION NATIONAL BLDG, WICHITA, KANSAS 67202

STATE OF KANSAS, COUNTY OF SEDGWICK, ss.
G. F. Galloway (~~owner~~ owner) or (owner or operator) of the above-described

well, being first duly sworn on oath, says: That I have knowledge of the facts, statements, and matters herein contained and the log of the above described well as filed and that the same are true and correct. So help me God.

(Signature) G. F. Galloway
G. F. Galloway 1107 Union Natl Bldg.
(Address)

Subscribed and sworn to before me this 16th day of August, 1973

My commission expires December 7, 1975
Phyllis Buchanan
Notary Public.

