

FEB - 1 1982

This form shall be filed in duplicate with the Kansas Corporation Commission, 200 Colorado Derby Building, Wichita, Kansas 67202, ^{CONSERVATION DIVISION} _{Wichita, Kansas} after the completion of the well, regardless of how the well was completed.

Attach separate letter of request if the information is to be held confidential. If confidential, only file one copy. Information on side one will be of public record and side two will then be held confidential.

Circle one: Oil Gas, Dry, SWD, OWNO, Injection. Type and complete ALL sections.

Applications must be filed for dual completion, commingling, SWD and injection, T.A.

Attach wireline logs (i.e. electrical log, sonic log, gamma ray neutron log, etc.).

KCC # (316) 263-3238. (Rules 82-2-105 & 82-2-125)

OPERATOR Columbia Petroleum Inc.

API NO. 15-163-21, 429 -00-00

ADDRESS Parkade Plaza, Suite 8

COUNTY Rooks

Columbia, MO. 65201

FIELD Rifes Extension RIFPE

**CONTACT PERSON Robert F. Randolph

PROD. FORMATION Arbuckle

PHONE (314) 449-2224

LEASE Kriley D

PURCHASER CRA Inc.

WELL NO. 3

ADDRESS P. O. Box 7305

WELL LOCATION NE SW SW

Kansas City, MO. 64116

DRILLING Emphasis Oil Operations

CONTRACTOR Emphasis Oil Operations

ADDRESS P. O. Box 506


990 Ft. from west Line and

990 Ft. from south Line of

the SW/4 SEC. 20 TWP. 7S RGE. 17W

Russell, KS. 67665

WELL PLAT

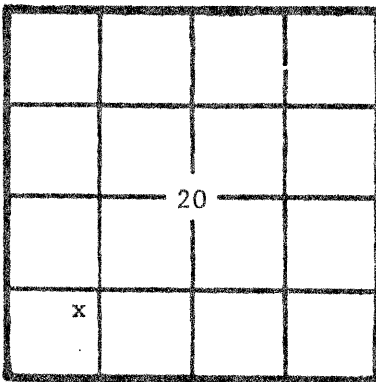

KCC
KGS
(Office Use)

PLUGGING _____

CONTRACTOR _____

ADDRESS _____

TOTAL DEPTH 3,238 PSTD _____

SPUD DATE 10/24/81 DATE COMPLETED 11/02/81

ELEV: GR 1,776 DF 1,779 KB 1,781

DRILLED WITH (CABLE) ROTARY (AIR) TOOLS

Amount of surface pipe set and cemented 1,180 DV Tool Used? _____

AFFIDAVIT

STATE OF MISSOURI, COUNTY OF BOONE SS, I, _____

ROBERT F. RANDOLPH OF LAWFUL AGE, BEING FIRST DULY SWORN UPON HIS OATH,

DEPOSES THAT HE IS vice president/comptroller (FOR)(OF) Columbia Petroleum Inc.

OPERATOR OF THE Kriley D LEASE, AND IS DULY AUTHORIZED TO MAKE

THIS AFFIDAVIT FOR AND ON THE BEHALF OF SAID OPERATOR, THAT WELL NO. 3 ON

SAID LEASE HAS BEEN COMPLETED AS OF THE 10th DAY OF November, 19 81, AND THAT

ALL INFORMATION ENTERED HEREIN WITH RESPECT TO SAID WELL IS TRUE AND CORRECT.

FURTHER AFFIANT SAITH NOT.

Rec'd
~~11-82~~
02-d-82

SUBSCRIBED AND SWORN BEFORE ME THIS 13 DAY OF Jan, 19 82.

MY COMMISSION EXPIRES: January 7, 1983

(S) Robert F. Randolph
Glenn E. Jett
NOTARY PUBLIC

**The person who can be reached by phone regarding any questions concerning this information. Within 45 days of completion, a witnessed initial test by the Commission is required if the well produces more than 25 BOPD or is located in a Basic Order Pool.

