

2-14-82

This form shall be filed in duplicate with the Kansas Corporation Commission, 200 Colorado Derby Building, Wichita, Kansas 67202, within ten days after the completion of the well, regardless of how the well was completed.

Attach separate letter of request if the information is to be held confidential. If confidential, only file one copy. Information on side one will be of public record and side two will then be held confidential.

Circle one: Oil Gas, Dry, SWD, OWNO, Injection. Type and complete ALL sections.

Applications must be filed for dual completion, commingling, SWD and injection, T.A.

Attach wireline logs (i.e. electrical log, sonic log, gamma ray neutron log, etc.).

KCC # (316) 263-3238. (Rules 82-2-105 & 82-2-125)

OPERATOR Columbia Petroleum Inc.

API NO. 15-163-21.118 -00-00

ADDRESS Parkade Plaza Suite 8

COUNTY Rooks

Columbia MO 65201

FIELD Rife Extension RIFFE

**CONTACT PERSON Robert F. Randolph

PROD. FORMATION Lansing/Kansas City

PHONE 449-2224

LEASE Schruben

PURCHASER CRA Inc.

WELL NO. 1

ADDRESS P. O. Box 7305

WELL LOCATION NW SW NW

Kansas City MO 64116

990 Ft. from east Line and

DRILLING Lawhanco Drilling Inc.

990 Ft. from south Line of


CONTRACTOR

ADDRESS P. O. Box 289

the NW SEC. 29 TWP. 7S RGE. 17W

Natoma, KS. 67651

WELL PLAT

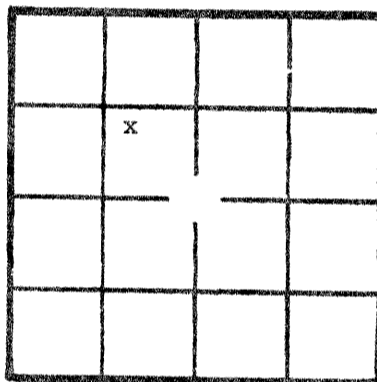

KCC [checked]
KGS [checked]
(Office Use)

PLUGGING

CONTRACTOR

ADDRESS

TOTAL DEPTH 3,317 PBD

SPUD DATE 7-11-80 DATE COMPLETED 7-18-80

ELEV: GR 1,808 DF 1,811 KB 1,813

DRILLED WITH (CABLE) ROTARY (AIR) TOOLS

Amount of surface pipe set and cemented 1,223' DV Tool Used?

AFFIDAVIT

STATE OF MISSOURI, COUNTY OF BOONE SS, I,

Robert F. Randolph OF LAWFUL AGE, BEING FIRST DULY SWORN UPON HIS OATH,

DEPOSES THAT HE IS vice president/comptroller (FOR) (OF) Columbia Petroleum Inc.

OPERATOR OF THE Schruben LEASE, AND IS DULY AUTHORIZED TO MAKE

THIS AFFIDAVIT FOR AND ON THE BEHALF OF SAID OPERATOR, THAT WELL NO. 1 ON

SAID LEASE HAS BEEN COMPLETED AS OF THE 10th DAY OF September, 19 80, AND THAT

ALL INFORMATION ENTERED HEREIN WITH RESPECT TO SAID WELL IS TRUE AND CORRECT.

FURTHER AFFIANT SAITH NOT.

SUBSCRIBED AND SWORN BEFORE ME THIS 13th DAY OF January, 19 82.

(S) Robert F. Randolph
Clara E. Jett
NOTARY PUBLIC

MY COMMISSION EXPIRES: January 7, 1983

**The person who can be reached by phone regarding any questions concerning this information. Within 45 days of completion, a witnessed initial test by the Commission is required if the well produces more than 25 BOPD or is located in a Basic Order Pool.