

CARD MUST BE TYPED

State of Kansas
NOTICE OF INTENTION TO DRILL
(see rules on reverse side)

CARD MUST BE SIGNED

Starting Date: March 18, 1985
month day year

API Number 15- 121-26,501-00-00

OPERATOR: License # 6168

East

Name Lester Scheuneman

SE 1/4 (location) Sec. 26 Twp 16 S, Rge 21 West

Address Box 331

1155 Ft North from Southeast Corner of Section

City/State/Zip Brookfield, Mo. 64628

450 Ft West from Southeast Corner of Section

Contact Person Lester Scheuneman

(Note: Locate well on Section Plat on reverse side)

Phone 913.755.2342

Nearest lease or unit boundary line 450 feet.

CONTRACTOR: License #

County Miami

Name Unkown

Lease Name Cummings Well# CA 2

City/State

Domestic well within 330 feet: yes no

Well Drilled For:

Well Class:

Type Equipment:

Oil Swd

Infield

Mud Rotary

Gas Inj

Pool Ext.

Air Rotary

OWWO Expl

Wildcat

Cable

Municipal well within one mile: yes no

Depth to Bottom of fresh water 200 feet

Lowest usable water formation unkown

Depth to Bottom of usable water unkown 200 feet

Surface pipe by Alternate: 1 2

Surface pipe to be set 20 feet

Conductor pipe if any required _____ feet

Ground surface elevation _____ feet MSL

This Authorization Expires 9-15-85

Approved By 3-15-85 *L.S.*

If OWWO: old well info as follows:

Operator _____

Well Name _____

Comp Date _____ Old Total Depth _____

Projected Total Depth 700 feet

Projected Formation at TD Squirell

Expected Producing Formations Squirell

I certify that we will comply with K.S.A. 55-101, et seq., plus eventually plugging hole to K.C.C. specifications.

Date 3-11-1985 Signature of Operator or Agent

Lester Scheuneman

Title Owner

Lester Scheuneman


Form C-1 4/84

KOP-RDHE 3-15-85

Must be filed with the K.C.C. five (5) days prior to commencing well
This card void if drilling not started within six (6) months of date received by K.C.C.

Important procedures to follow :

**A Regular Section of Land
1 Mile = 5,280 Ft.**

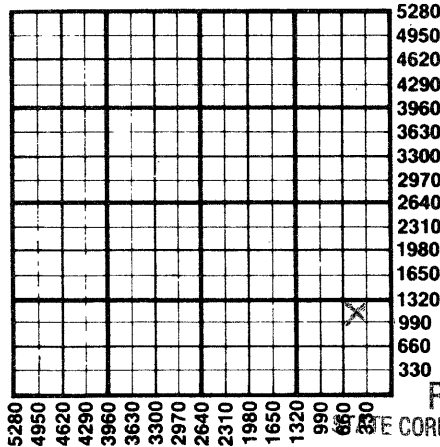

1. Notify District office before setting surface casing.
2. Set surface casing by circulating cement to the top.
3. File completion forms ACO-1 with K.C.C. within 90 days of well completion, following instructions on ACO-1, side 1, and including copies of wireline logs.
4. Notify District office 48 hours prior to old well workover or re-entry.
5. Prior to plugging, prepare a plugging plan, then obtain agreement from the appropriate district office for an approved plugging plan.
6. Submit plugging report (CP-4) to K.C.C. after plugging is completed.
7. Obtain an approved injection docket number before disposing of salt water.
8. Notify K.C.C. within 10 days when injection commences or terminates.
9. If an alternate 2 completion, cement in the production pipe from below any usable water to surface within 120 days of spud date.

RECEIVED

STATE CORPORATION COMMISSION

State Corporation Commission of Kansas
Conservation Division
200 Colorado Derby Building
Wichita, Kansas 67202
(316) 263-3238

MAR 15 1985

CONSERVATION DIVISION
Wichita, Kansas