

CARD MUST BE TYPED

State of Kansas
NOTICE OF INTENTION TO DRILL
(see rules on reverse side)

CARD MUST BE SIGNED

Starting Date: March 20, 1985
month day year

API Number 15- 121-26,502-00-00

OPERATOR: License # 6168
Name Lester Scheuneman
Address Box 331
City/State/Zip Brookfield, Mo. 64628
Contact Person Lester Scheuneman
Phone 913.755.2342

SE $\frac{1}{2}$ (location) Sec 26 Twp 16 S, Rge 21 East West

855 Ft North from Southeast Corner of Section
615 Ft West from Southeast Corner of Section
(Note: Locate well on Section Plat on reverse side)

CONTRACTOR: License #
Name Unkown
City/State

Nearest lease or unit boundary line 615 feet.
County Miami
Lease Name Cummings Well# CA.3

Domestic well within 330 feet: yes no
Municipal well within one mile: yes no

Well Drilled For: Well Class: Type Equipment:
 Oil Swd Infield Mud Rotary
 Gas Inj Pool Ext. Air Rotary
 OWWO Expl Wildcat Cable

Depth to Bottom of fresh water 200 feet
Lowest usable water formation unkown
Depth to Bottom of usable water unkown feet
Surface pipe by Alternate: 1 2
Surface pipe to be set 20 feet
Conductor pipe if any required _____ feet
Ground surface elevation _____ feet MSL
This Authorization Expires 9-15-85
Approved By 3-15-85 *RS*

If OWWO: old well info as follows:

Operator _____
Well Name _____
Comp Date _____ Old Total Depth _____
Projected Total Depth 700 feet
Projected Formation at TD Squirell
Expected Producing Formations Squirell

I certify that we will comply with K.S.A. 55-101, et seq., plus eventually plugging hole to K.C.C. specifications.

Date 3-11-1985 Signature of Operator or Agent Lester Scheuneman Title _____

Owner _____


Form C-1 4/84

KOP-KDHE 3-15-85

**Must be filed with the K.C.C. five (5) days prior to commencing well
This card void if drilling not started within six (6) months of date received by K.C.C.**

Important procedures to follow :

**A Regular Section of Land
1 Mile = 5,280 Ft.**

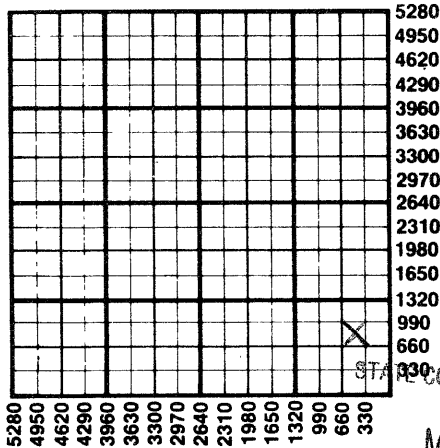

1. Notify District office before setting surface casing.
2. Set surface casing by circulating cement to the top.
3. File completion forms ACO-1 with K.C.C. within 90 days of well completion, following instructions on ACO-1, side 1, and including copies of wireline logs.
4. Notify District office 48 hours prior to old well workover or re-entry.
5. Prior to plugging, prepare a plugging plan, then obtain agreement from the appropriate district office for an approved plugging plan.
6. Submit plugging report (CP-4) to K.C.C. after plugging is completed.
7. Obtain an approved injection docket number before disposing of salt water.
8. Notify K.C.C. within 10 days when injection commences or terminates.

RECEIVED
STATE CORPORATION COMMISSION
 If an alternate 2 completion, cement in the production pipe from below
 any usable water to surface within 120 days of spud date.

MAR 15 1985
CONSERVATION DIVISION
 Wichita, Kansas

State Corporation Commission of Kansas
Conservation Division
200 Colorado Derby Building
Wichita, Kansas 67202
(316) 263-3238