

CARD MUST BE TYPED

State of Kansas
NOTICE OF INTENTION TO DRILL
(see rules on reverse side)

CARD MUST BE SIGNED

Starting Date: April.....26.....1985.....
month day year

API Number 15- 121-26,521-00-00

OPERATOR: License # 6168.....
Name Lester Scheuneman.....
Address Box 331.....
City/State/Zip Brookfield, Mo. 64628.....
Contact Person Lester Scheuneman.....
Phone 913-755-2342.....

NE SE₄ SE..... Sec 26 Twp 16 S, Rge 21.....
(location) East West

CONTRACTOR: License #
Name Unknown.....
City/State

.1000..... Ft North from Southeast Corner of Section
.600..... Ft West from Southeast Corner of Section
(Note: Locate well on Section Plat on reverse side)

Nearest lease or unit boundary line .600..... feet.
County Miami.....

Lease Name Cummings..... Well# CA #4.....

Domestic well within 330 feet: yes no

Municipal well within one mile: yes no

Well Drilled For: Well Class: Type Equipment:

Oil Swd Infield Mud Rotary
 Gas Inj Pool Ext. Air Rotary
 OWWO Expl Wildcat Cable

Depth to Bottom of fresh water 200..... feet

Lowest usable water formation unknown.....

Depth to Bottom of usable water 200..... feet

Surface pipe by Alternate: 1 2

Surface pipe to be set 20..... feet

Conductor pipe if any required feet

Ground surface elevation feet MSL

This Authorization Expires 10-22-85.....

Approved By 4-22-85 *LS*.....

If OWWO: old well info as follows:

Operator

Well Name

Comp Date Old Total Depth

Projected Total Depth 700..... feet

Projected Formation at TD Squirell.....

Expected Producing Formations Squirell.....

I certify that we will comply with K.S.A. 55-101, et seq., plus eventually plugging hole to K.C.C. specifications.

Date 4-18-1985 Signature of Operator or Agent

Lester Scheuneman
Lester Scheuneman

Title Owner

MHC 1/10/85 4-22-85


Must be filed with the K.C.C. five (5) days prior to commencing well
 This card void if drilling not started within six (6) months of date received by K.C.C.

RECEIVED
 STATE CORPORATION COMMISSION

APR 22 1985

Important procedures to follow:

**A Regular Section of Land
 1 Mile = 5,280 Ft.**

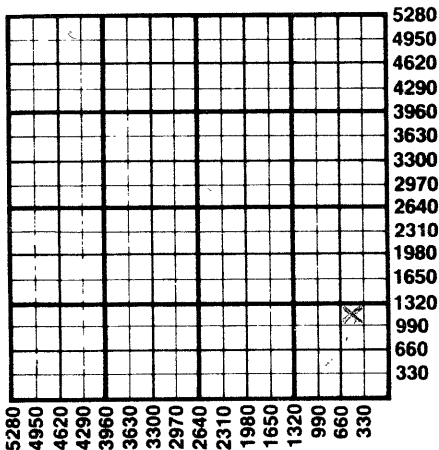

1. Notify District office before setting surface casing.
2. Set surface casing by circulating cement to the top.
3. File completion forms ACO-1 with K.C.C. within 90 days of well completion, following instructions on ACO-1, side 1, and including copies of wireline logs.
4. Notify District office 48 hours prior to old well workover or re-entry.
5. Prior to plugging, prepare a plugging plan, then obtain agreement from the appropriate district office for an approved plugging plan.
6. Submit plugging report (CP-4) to K.C.C. after plugging is completed.
7. Obtain an approved injection docket number before disposing of salt water.
8. Notify K.C.C. within 10 days when injection commences or terminates.
9. If an alternate 2 completion, cement in the production pipe from below any usable water to surface within 120 days of spud date.

CONSERVATION DIVISION
 Wichita, Kansas

State Corporation Commission of Kansas
 Conservation Division
 200 Colorado Derby Building
 Wichita, Kansas 67202
 (316) 263-3238