

CARD MUST BE TYPED

State of Kansas  
**NOTICE OF INTENTION TO DRILL**

CARD MUST BE SIGNED

5 days after approval

(see rules on reverse side)

Starting Date: 12 8 84  
month day year

API Number 15- 121-26, 450-00-00

OPERATOR: License # 5095

NE SE 1/4 (location) Sec . 25 Twp . 16 S, Rge . 21  East  West

Name Gerald E. Williams

Address P.O. Box 25830

City/State/Zip O.P., KS 66225

Contact Person Gerald E. Williams

Phone 913-451-6022

2,000 Ft North from Southeast Corner of Section

800 Ft West from Southeast Corner of Section

(Note: Locate well on Section Plat on reverse side)

CONTRACTOR: License # 5353

Nearest lease or unit boundary line 165 feet.

County Miami

Name Bloomer Well Service

Lease Name Linsley Well# 6

City/State Rantoul, KS 66079

Domestic well within 330 feet:  yes  no

Municipal well within one mile:  yes  no

Well Drilled For: Well Class: Type Equipment:

- Oil  Swd  Infield  Mud Rotary
- Gas  Inj  Pool Ext.  Air Rotary
- OWWO  Expl  Wildcat  Cable

Depth to Bottom of fresh water 20 feet

Lowest usable water formation ~~20~~

Depth to Bottom of usable water 250 feet

Surface pipe by Alternate: 1  2

Surface pipe to be set 20 feet

Conductor pipe if any required none feet

Ground surface elevation n/a feet MSL

This Authorization Expires 6-3-85

Approved By 12-3-84 *He*

If OWWO: old well info as follows:

Operator

Well Name

Comp Date Old Total Depth

Projected Total Depth 750 feet

Projected Formation at TD 700

Expected Producing Formations squirrel

I certify that we will comply with K.S.A. 55-101, et seq., plus eventually plugging hole to K.C.C. specifications.

Date 11/19/84 Signature of Operator or Agent


Title Operator

MHC/KOHE 12/3/84

**Must be filed with the K.C.C. five (5) days prior to commencing well  
This card void if drilling not started within six (6) months of date received by K.C.C.**

**Important procedures to follow :**

**A Regular Section of Land  
1 Mile = 5,280 Ft.**

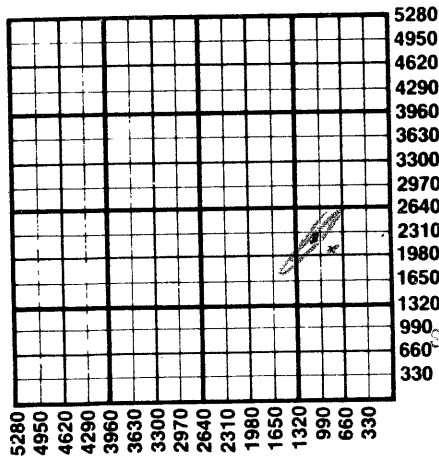

1. Notify District office before setting surface casing.
2. Set surface casing by circulating cement to the top.
3. File completion forms ACO-1 with K.C.C. within 90 days of well completion, following instructions on ACO-1, side 1, and including copies of wireline logs.
4. Notify District office 48 hours prior to old well workover or re-entry.
5. Prior to plugging, prepare a plugging plan, then obtain agreement from the appropriate district office for an approved plugging plan.
6. Submit plugging report (CP-4) to K.C.C. after plugging is completed.
7. Obtain an approved injection docket number before disposing of salt water.
8. Notify K.C.C. within 10 days when injection commences or terminates.
9. If an alternate completion, cement in the production pipe from below any usable water to surface within 120 days of spud date.

RECEIVED  
STATE CORPORATION COMMISSION  
DEC 03 1984  
12-03-84  
CONSERVATION DIVISION  
Wichita, Kansas

State Corporation Commission of Kansas  
Conservation Division  
200 Colorado Derby Building  
Wichita, Kansas 67202  
(316) 263-3238