

CARD MUST BE TYPED

State of Kansas

CARD MUST BE SIGNED

NOTICE OF INTENTION TO DRILL

(see rules on reverse side)

Starting Date Sept. 16, 1985
month day year *11:00*

API Number 15— *121-26,659-a-00*

OPERATOR: License # 6715 app. SE SW NE Sec. 25 Twp. 16 S, Rg. 21 East
Name William J. Burns 3080 Ft. from South Line of Section
Address 9650 Chadwick 1910 Ft. from East Line of Section
City/State/Zip Shawnee Mission, KS 66206
Contact Person William J. Burns
Phone (913) 649-1312
(Note: Locate well on Section Plat on reverse side)

CONTRACTOR: License #
Name Company Tools
City/State

Nearest lease or unit boundary line 530 feet
County Miami
Lease Name Tisdale Well # 14
Ground surface elevation na feet MSL
Domestic well within 330 feet: yes no
Municipal well within one mile: yes no
Surface pipe by Alternate: 1 2 *220*
Depth to bottom of fresh water ~~none~~
Depth to bottom of usable water 200
Surface pipe planned to be set 20
Projected Total Depth 725 feet
Formation

Well Drilled For: Well Class: Type Equipment:
 Oil SWD Infield Mud Rotary
 Gas Inj Pool Ext. Air Rotary
 OWWO Expl Wildcat Cable

If OWWO: old well info as follows:
Operator
Well Name
Comp Date Old Total Depth

I certify that well will comply with K.S.A. 55-101, et seq., plus eventually plugging hole to KCC specifications.

PCAS FONE
_____ cementing will be done immediately upon setting production casing.
Date 9/12/85 .. Signature of Operator or Agent *Juan Carlos* Title ... As. Agent

For KCC Use:
Conductor Pipe Required feet; Minimum Surface Pipe Required feet per *1* 1 2
This Authorization Expires *3-12-86* Approved By *9-12-85* *[Signature]*

Must be filed with the K.C.C. five (5) days prior to commencing well
 This card void if drilling not started within six (6) months of date received by K.C.C.

Important procedures to follow:

RECEIVED
 STATE CORPORATION COMMISSION

District office before setting surface casing.

A Regular Section of Land
 1 Mile = 5,280 Ft.

SEP 12 1985

Set surface casing by circulating cement to the top.

CONSERVATION DIVISION
 Wichita, Kansas

3. File completion forms ACO-1 with K.C.C. within 90 days of well completion, following instructions on ACO-1, side 1, and including copies of wireline logs.

4. Notify District office 48 hours prior to old well workover or re-entry.


5. Prior to filing Intent, prepare a proposed plugging plan in case well is D & A, then obtain approval of plan when calling district office prior to setting surface pipe.

6. Submit plugging report (CP-4) to K.C.C. after plugging is completed.

7. Obtain an approved injection docket number before disposing of salt water.

8. Notify K.C.C. within 10 days when injection commences or terminates.

9. If an alternate 2 completion, cement in the production pipe from below any usable water to surface within 120 days of spud date.

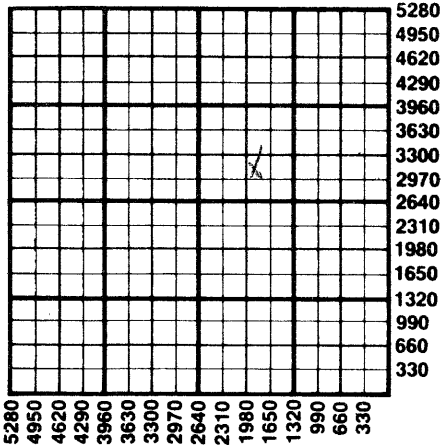

State Corporation Commission of Kansas
 Conservation Division
 200 Colorado Derby Building
 Wichita, Kansas 67202
 (316) 263-3238