

CARD MUST BE TYPED

State of Kansas
NOTICE OF INTENTION TO DRILL

CARD MUST BE SIGNED

5 ~~days~~ after approval

(see rules on reverse side)

Starting Date: 12 / 8 / 84 /
month day year

API Number 15- 121-26,451-00-00

OPERATOR: License # 5095

Name Gerald E. Williams

Address .. P.O. Box 25830

City/State/Zip .. O.P., KS 66225

Contact Person ... Gerald E. Williams

Phone 913-451-6022

CONTRACTOR: License # ... 5353

Name Bloomer Well Service

City/State Rantoul, KS 66079

Well Drilled For: Well Class: Type Equipment:

- Oil Swd Infield Mud Rotary
- Gas Inj Pool Ext. Air Rotary
- OWWO Expl Wildcat Cable

If OWWO: old well info as follows:

Operator

Well Name

Comp Date Old Total Depth

Projected Total Depth 750 feet

Projected Formation at TD 700

Expected Producing Formations squirrel

SE 1/4.. Sec .25 Twp .16. S, Rge .21 East
(location) West

2,165..... Ft North from Southeast Corner of Section
950..... Ft West from Southeast Corner of Section
(Note: Locate well on Section Plat on reverse side)

Nearest lease or unit boundary line 25 feet.

County Miami

Lease Name Linsley Well# ... 7

Domestic well within 330 feet: yes no (ww2)

Municipal well within one mile: yes no

Depth to Bottom of fresh water 20 feet

Lowest usable water formation 20 feet

Depth to Bottom of usable water 250 feet

Surface pipe by Alternate: 1 2

Surface pipe to be set 20 feet

Conductor pipe if any required none feet

Ground surface elevation n/a feet MSL

This Authorization Expires 6-3-85

Approved By 12-3-84 [Signature]

I certify that we will comply with K.S.A. 55-101, et seq., plus eventually plugging hole to K.C.C. specifications.

Date .. 11/19/84 .. Signature of Operator or Agent

[Signature]


Title Operator

MHC/LW/DHE 12/3/84 Form C-1 4/84

**Must be filed with the K.C.C. five (5) days prior to commencing well
This card void if drilling not started within six (6) months of date received by K.C.C.**

Important procedures to follow:

**A Regular Section of Land
1 Mile = 5,280 Ft.**

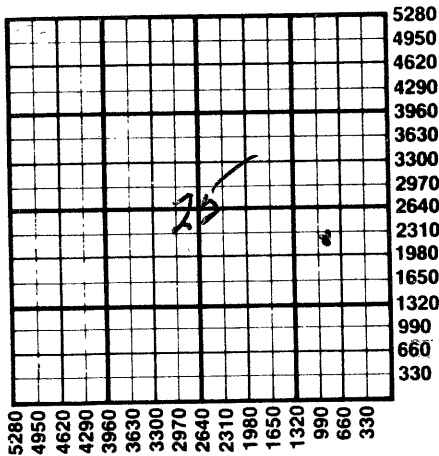

1. Notify District office before setting surface casing.
2. Set surface casing by circulating cement to the top.
3. File completion forms ACO-1 with K.C.C. within 90 days of well completion, following instructions on ACO-1, side 1, and including copies of wireline logs.
4. Notify District office 48 hours prior to old well workover or re-entry.
5. Prior to plugging, prepare a plugging plan, then obtain agreement from the appropriate district office for an approved plugging plan.
6. Submit plugging report (CP-4) to K.C.C. after plugging is completed.
7. Obtain an approved injection docket number before disposing of salt water.
8. Notify K.C.C. within 10 days when injection commences or terminates.
9. If an alternate completion, cement in the production pipe from below any usable water to surface within 120 days of spud date.

DEC 03 1984
12-03-84
CONSERVATION DIVISION
Wichita, Kansas

**State Corporation Commission of Kansas
Conservation Division
200 Colorado Derby Building
Wichita, Kansas 67202
(316) 263-3238**