

CARD MUST BE TYPED

State of Kansas
NOTICE OF INTENTION TO DRILL
(see rules on reverse side)

CARD MUST BE SIGNED

Starting Date:5.....24.....1985.....
month day year

API Number 15- 121-26,547-00-00

OPERATOR: License # 6756
Name McGown Oil, Inc.
Address Box 216
City/State/Zip Mound City, KS 66056
Contact Person Gib McGown
Phone (913) 795-2258

App. NE NE SW Sec .25 Twp .16 S, Rge .21. East
(location) West

2243..... Ft North from Southeast Corner of Section
2895..... Ft West from Southeast Corner of Section
(Note: Locate well on Section Plat on reverse side)

CONTRACTOR: License # 5786
Name McGown Drilling Inc.
City/State Mound City, KS 66056

Nearest lease or unit boundary line 1340..... feet.
County Miami.....
Lease Name Barnett Pflug..... Well# I-1.....

Well Drilled For: **Well Class:** **Type Equipment:**
 Oil Swd Infield Mud Rotary
 Gas Inj Pool Ext. Air Rotary
 OWWO Expl Wildcat Cable

Domestic well within 330 feet: yes no
Municipal well within one mile: yes no

If OWWO: old well info as follows:

Operator
Well Name
Comp Date Old Total Depth
Projected Total Depth 700..... feet
Projected Formation at TD Squirrel.....
Expected Producing Formations

Depth to Bottom of fresh water 40..... feet
Lowest usable water formation Kansas City Group.....
Depth to Bottom of usable water 300..... feet
Surface pipe by Alternate: 1 2
Surface pipe to be set 20..... feet
Conductor pipe if any required feet
Ground surface elevation feet MSL

This Authorization Expires 11-23-85
Approved By S. J. [Signature]

I certify that we will comply with K.S.A. 55-101, et seq., plus eventually plugging hole to K.C.C. specifications.

Date 5/23/85..... Signature of Operator or Agent [Signature] Title As Agent.....

CONSERVATION DIVISION
WICHITA, KANSAS

Must be filed with the K.C.C. five (5) days prior to commencing well
This card void if drilling not started within six (6) months of date received by K.C.C.

MAY 23 1985


05-23-85

STATE CORPORATION COMMISSION

RECEIVED

A Regular Section of Land

1 Mile = 5,280 Ft.

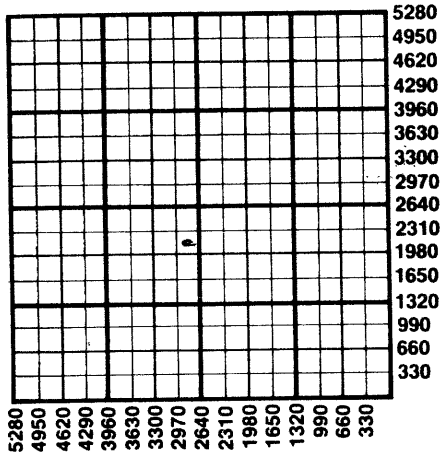

Important procedures to follow :

1. Notify District office before setting surface casing.
2. Set surface casing by circulating cement to the top.
3. File completion forms ACO-1 with K.C.C. within 90 days of well completion, following instructions on ACO-1, side 1, and including copies of wireline logs.
4. Notify District office 48 hours prior to old well workover or re-entry.
5. Prior to plugging, prepare a plugging plan, then obtain agreement from the appropriate district office for an approved plugging plan.
6. Submit plugging report (CP-4) to K.C.C. after plugging is completed.
7. Obtain an approved injection docket number before disposing of salt water.
8. Notify K.C.C. within 10 days when injection commences or terminates.
9. If an alternate 2 completion, cement in the production pipe from below any usable water to surface within 120 days of spud date.

State Corporation Commission of Kansas
Conservation Division
200 Colorado Derby Building
Wichita, Kansas 67202
(316) 263-3238