


15-163-21377-00-00

STATE OF KANSAS
STATE CORPORATION COMMISSION

WELL PLUGGING RECORD

Give All Information Completely
Make Required Affidavit
Mail or Deliver Report to
Conservation Division
State Corporation Comm.
245 North Water
Wichita, KS 67202

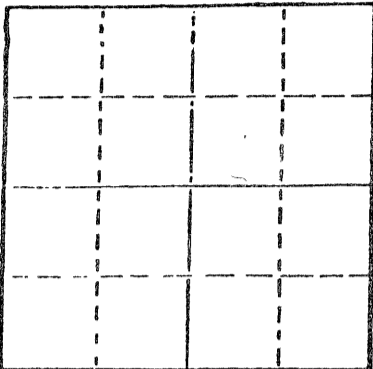

Locate well correctly on above
Section Plot

Rooks County. Sec. 18 Twp. 7 Rge. 17w E/W
Location as "NE/CNW $\frac{1}{4}$ SW $\frac{1}{4}$ " or footage from lines 330' from
S. line 990' from W. line of the N/2 NE/4
Lease Owner The Gene Brown Company
Lease Name Dix Well No. 1
Office Address 407 S. Main Plainville, Kansas 67663
Character of Well (Completed as Oil, Gas or Dry Hole) dry hole
Date Well completed 8-18-81 19
Application for plugging filed 8-18-81 19
Application for plugging approved 8-18-81 19
Plugging commenced 2:45 A. M. 8-18-81 19
Plugging completed 4:00 A.M. 8-18-81 19
Reason for abandonment of well or producing formation dry hole

If a producing well is abandoned, date of last production 19

Was permission obtained from the Conservation Division or its agents before plugging was commenced? yes

Name of Conservation Agent who supervised plugging of this well Marion Schmidt
Producing formation _____ Depth to top _____ Bottom _____ Total Depth of Well _____
Show depth and thickness of all water, oil and gas formations.

OIL, GAS OR WATER RECORDS

CASING RECORD

FORMATION	CONTENT	FROM	TO	SIZE	PUT IN	PULLED OUT

Describe in detail the manner in which the well was plugged, indicating where the mud fluid was placed and the method or methods used in introducing it into the hold. If cement or other plugs were used, state the character of same and depth placed, from _____ feet to _____ feet for each plug set.

spotted 60 sacks at 760'
spotted 40 sacks at 240'
spotted 10 sacks at 40' with 1/2 sack hulls and plug for bridge
Plugged rat hole with 5 sacks
Total 115 sacks 50/50 poz 6% gel

RECEIVED
STATE CORPORATION COMMISSION
08-20-1981
AUG 20 1981
CONSERVATION DIVISION
Wichita Kansas

(If additional description is necessary, use BACK of this report)
Name of Plugging Contractor Lawbanco Drilling, Inc.
Box 289 Natoma, Kansas 67651

STATE OF Kansas COUNTY OF Osborne, ss.
R. L. Finnesy (employee of owner) or (owner or operator)


of the above-described well, being first duly sworn on oath, says: That I have knowledge of the facts, statements, and matters herein contained and the log of the above-described well as filed and that the same are true and correct. So help me God.

(Signature) R. L. Finnesy
2220 Marjorie Hays, Kansas 67601
(Address)

SUBSCRIBED AND SWORN TO before me this 19th day of August, 19 81

Kathy Hachmeister
Notary Public.

My commission expires

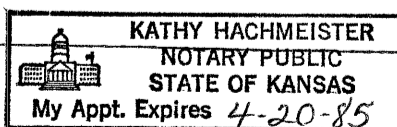

Kathy Hachmeister