


Give All Information Completely
Make Required Affidavit
Mail or Deliver Report to:
Conservation Division
State Corporation Commission
800 Bitting Building
Wichita, Kansas

OR
FORMATION PLUGGING RECORD

Strike out upper line
when reporting plug-
ging off formations.

Rooks County. Sec. 23 Twp. 7S Rge. (E) 17 (W)

Location as "NE $\frac{1}{4}$ NW $\frac{1}{4}$ SW $\frac{1}{4}$ " or footage from lines NW SE NW
Lease Owner... Glenn W. Peel Oil Producer
Lease Name... Reed Well No. 1
Office Address... P.O. Box 359, Hoisington, Kansas
Character of Well (completed as Oil, Gas or Dry Hole) Dry Hole
Date well completed... June 9 1948
Application for plugging filed... June 9 1948
Application for plugging approved... June 9 1948
Plugging commenced... June 9 1948
Plugging completed... June 9 1948
Reason for abandonment of well or producing formation Dry Hole

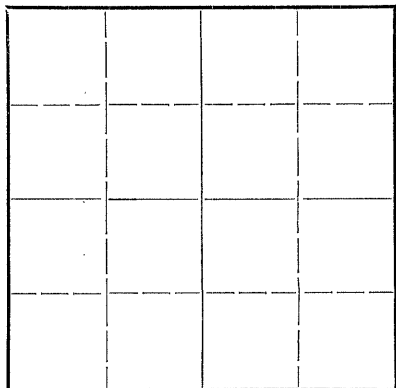

Locate well correctly on above
Section Plat

If a producing well is abandoned, date of last production... 19...
Was permission obtained from the Conservation Division or its agents before plugging was com-
menced? Yes

Name of Conservation Agent who supervised plugging of this well Merl Rives
Producing formation... Depth to top... Bottom... Total Depth of Well 3350 Feet
Show depth and thickness of all water, oil and gas formations.

OIL, GAS OR WATER RECORDS

CASING RECORD

Formation	Content	From	To	Size	Put In	Pulled Out
		0	112'	12 $\frac{1}{2}$ "	112'	None
		0	859'	8 5/8"	859'	None

Describe in detail the manner in which the well was plugged, indicating where the mud fluid was placed and the method or methods used in introducing it into the hold. If cement or other plugs were used, state the character of same and depth placed, from... feet to

- From 3350' to 859' - Heavy rotary mud
- " 859' to 857 $\frac{1}{2}$ ' - Wooden plug
- " 857 $\frac{1}{2}$ ' to 827 $\frac{1}{2}$ ' - 15 sacks cement by Halliburton
- " 827 $\frac{1}{2}$ ' to 200' - Heavy rotary mud
- " 200' to 198 $\frac{1}{2}$ ' - Wooden plug
- " 198 $\frac{1}{2}$ ' to 178 $\frac{1}{2}$ ' - 10 sacks cement
- " 178 $\frac{1}{2}$ ' to 35' - Heavy rotary mud
- " 35' to 33 $\frac{1}{2}$ ' - Wooden plug
- " 33 $\frac{1}{2}$ ' to 6' - 10 sacks cement and rock
- " 6' to surface - Cellar

(If additional description is necessary, use BACK of this sheet)

Correspondence regarding this well should be addressed to Glenn W. Peel Oil Producer
Address P.O. Box 359, Hoisington, Kansas

STATE OF Kansas, COUNTY OF Barton, ss.
Glenn W. Peel Oil Producer (owner or operator) of the above-described well,

being first duly sworn on oath, says: That I have knowledge of the facts, statements, and matters herein contained and the log of the above-described well as filed and that the same are true and correct. So help me God. Glenn W. Peel Oil Producer


(Signature) By: *Mendell E. Peel*

P.O. Box 359, Hoisington, Kansas
(Address)

SUBSCRIBED AND SWORN TO before me this 14th day of June, 1948

Marian M. Herdick
Notary Public.

My commission expires June 4, 1951

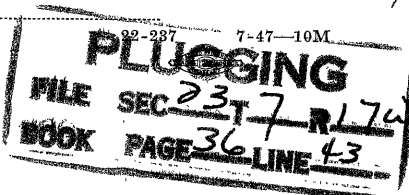

JUN 15 1948
6-15-48

DRILLER'S LOG

Company: Glenn W. Peel Oil Producer

Sec. 23 Twp. 7S Rge. 17W
NW SE NW

Farm: Reed Well No. 1

County: Rooks
Kansas

Total Depth: 3350'

Comm.: 5-25-48; Comp.: 6-9-48.

Contractor: Glenn Peel Drlg. Co., Inc.

Elevation:

Casing:

12 1/2" 112' cem.

8 5/8" 859' cem.

Production: Dry

Figures below indicate bottom of formations

Shale	0 -	140
Sand		190
Shale		240
Sand		490
Sand and Shale w/iron streaks		685
Shale and Shell		695
Shale and Sand		815
Iron and Shale		865
Shale and Shell		892
Shale		920
Red Bed Shale		1115
Anhydrite		1155
Shale and Shell		1670
Lime		1690
Shale and Lime		1855
Lime		1935
Shale and Lime		2160
Lime and Shale Streaks		2255
Shale and Lime		2450
Lime and Shale		2655
Lime		2705
Broken Lime		2735
Lime		3260
Conglomerate		3318
Arbuckle Lime		3350
Total Depth		3350

This is to certify that the above information is, to the best of our knowledge, true and correct.

GLENN PEEL DRILLING CO., INC.

BY: *Glenn W. Peel*

SUBSCRIBED AND SWORN to before me this 14th day of June, 1948

My commission expires June 4, 1951

Marian M. Hester
Notary Public

PLUGGING
FILE SEC 23-7-R-170
BOOK PAGE 36 LINE 43

6-15-48
JUN 15 1948