

15-163-21913-00-00

STATE OF KANSAS  
STATE CORPORATION COMMISSION

WELL PLUGGING RECORD

Give All Information Completely  
Make Required Affidavit  
Mail or Deliver Report to  
Conservation Division  
State Corporation Comm.  
245 North Water  
Wichita, KS 67202

Rooks County, Sec. 25 Twp. 7S Rge. 17 NE/W  
Location as "NE/CNW $\frac{1}{4}$ SW $\frac{1}{4}$ " or footage from lines  
SW SE


Lease Owner Irex Corporation  
Lease Name Casad. Well No. #1  
Office Address 1670 Broadway - Suite 3301, Denver, CO  
Character of Well (Completed as Oil, Gas or Dry Hole)  
Dry Hole

Date Well completed 12-29-82 19  
Application for plugging filed 12-29-82 19  
Application for plugging approved 12-29-82 19  
Plugging commenced 12-29-82 19  
Plugging completed 12-29-82 19

Reason for abandonment of well or producing formation  
Commercial quantities of oil not found  
If a producing well is abandoned, date of last production 19.

Was permission obtained from the Conservation Division or its agents before plugging was commenced? Yes

Name of Conservation Agent who supervised plugging of this well Dennis Hamel  
Producing formation \_\_\_\_\_ Depth to top \_\_\_\_\_ Bottom \_\_\_\_\_ Total Depth of Well 3411'  
Show depth and thickness of all water, oil and gas formations.

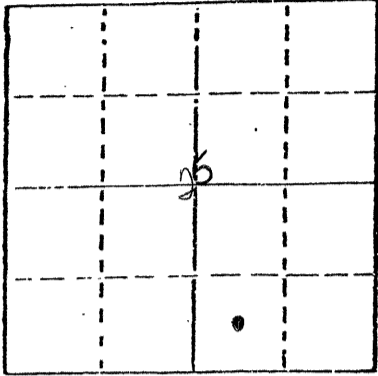

Locate well correctly on above Section Plot

OIL, GAS OR WATER RECORDS

CASING RECORD

FORMATION	CONTENT	FROM	TO	SIZE	PUT IN	PULLED OUT
				8 5/8"	252'	None

Describe in detail the manner in which the well was plugged, indicating where the mud fluid was placed and the method or methods used in introducing it into the hold. If cement or other plugs were used, state the character of same and depth placed, from \_\_\_\_\_ feet to \_\_\_\_\_ feet for each plug-set.

- Plug @ 3411' w/20 sx.
- Plug @ 1285' w/20 sx.
- Plug @ 800' w/100 sx.
- Plug @ 260' w/40 sx.
- Plug @ 40' w/10 sx.
- Rat Hole 10 sx.

(If additional description is necessary, use BACK of this sheet)

Name of Plugging Contractor Rains & Williamson Oil Co., Inc.

STATE OF Kansas COUNTY OF Sedgwick, ss.

Wilson Rains, President of Rains & Williamson Oil Co., (employee of owner) or (owner or operator) of the above-described well, being first duly sworn on oath, says: That I have knowledge of the facts, statements, and matters herein contained and the log of the above-described well as filed and that the same are true and correct. So help me God.

(Signature) Wilson Rains  
435 Page Court, 220 W. Douglas, Wichita, Ks. 67202  
(Address)

SUBSCRIBED AND SWORN TO before me this 3 day of January, 1983

Juanita M. Green  
Juanita M. Green Notary Public.

My commission expires 10-4-83

RECEIVED  
STATE CORPORATION COMMISSION

JAN 21 1983  
1-21-83  
CONSERVATION DIVISION  
Wichita, Kansas

