

WELL PLUGGING RECORD

Give All Information Completely  
Make Required Affidavit  
Mail or Deliver Report to  
Conservation Division  
State Corporation Comm.  
200 Colorado Derby Bldg.  
202 W. 1st St.  
Wichita, KS 67202

Rooks County Sec. 29 Twp. 7S Rge. 17  E/W  
Location as "NE/CNW/SW" or footage from lines \_\_\_\_\_

NW SW NE

Lease Owner Liberty Enterprises, Inc.

Lease Name Schruben Well No. #1

Office Address 308 West Mill Plainville, Kansas 67663

Character of Well (Completed as Oil, Gas or Dry Hole) \_\_\_\_\_  
Dry Hole

Date Well completed \_\_\_\_\_ 8-6 19 81

Application for plugging filed \_\_\_\_\_ 8-6 19 81

Application for plugging approved \_\_\_\_\_ 8-6 19 81

Plugging commenced \_\_\_\_\_ 5:30 P.M. 8-6 19 81

Plugging completed \_\_\_\_\_ 6:15 P.M. 8-6 19 81

Reason for abandonment of well or producing formation \_\_\_\_\_  
No Commercial Production


If a producing well is abandoned, date of last production \_\_\_\_\_  
19 \_\_\_\_\_

Was permission obtained from the Conservation Division or its agents before plugging was commenced? Yes

Name of Conservation Agent who supervised plugging of this well Marion Schmidt

Producing formation \_\_\_\_\_ Depth to top \_\_\_\_\_ Bottom \_\_\_\_\_ Tl. Depth of Well \_\_\_\_\_

Show depth and thickness of all water, oil and gas formations.

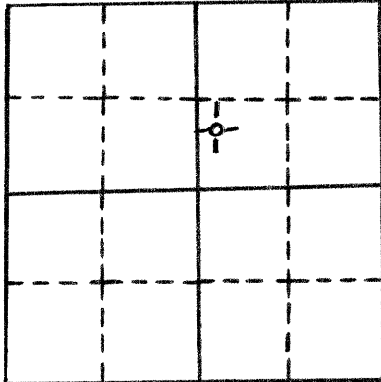

locate well correctly  
on above  
Section Plot

OIL, GAS OR WATER RECORDS

CASING RECORD

FORMATION	CONTENT	FROM	TO	SIZE	PUT IN	PULLED OUT
Surface casing	60-40 pos	0'	1213'	8 5/8"	1213'	0'

Describe in detail the manner in which the well was plugged, indicating where the mud fluid was placed and the method or methods used in introducing it into the hold. If cement or other plugs were used, state the character of same and depth placed, from \_\_\_\_\_ feet to \_\_\_\_\_ feet for each plug set.

Plug #1 1200' with 55 sxs

Plug #2 270' with 40 sxs

Plug #3 40' with 10 sxs

5 sxs in rathole

Total - 110 sxs 50-50- pos 4%gel 3%cc

P.D. @ 6:15 P.M.

(If additional description is necessary, use BACK of this sheet)

Name of Plugging Contractor Pioneer Drilling Co, Inc.

308 West Mill Plainville, Ks 67663


8-10-81

STATE OF Kansas COUNTY OF Rooks


Liberty Enterprises, Inc. (employee of owner) or (owner/operator) of the above described well, being first duly sworn on oath, says: That I have knowledge of the facts, statements, and matters herein contained and the log of the above described well is filed and that the same are true and correct. So help me God.

(Signature) David R. Conner

(Address) 308 W. MILL Plainville, Ks

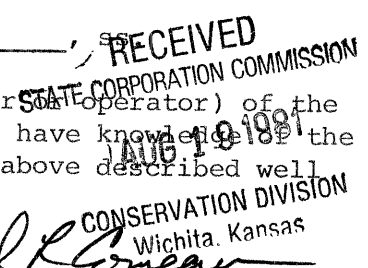

SUBSCRIBED AND SWORN TO before me this 18 day of August, 19 81

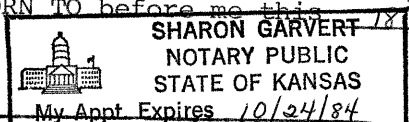

My commission expires \_\_\_\_\_

Sharon Garvert  
Notary Public