

CARD MUST BE TYPED

State of Kansas  
**NOTICE OF INTENTION TO DRILL**  
(see rules on reverse side)

CARD MUST BE SIGNED

Starting Date: Nov. 15, 1984  
month day year

API Number 15- 163-22,542-00-00

OPERATOR: License # 7011  
Name Rim Oil Co.  
Address 2101 Lincoln Drive  
City/State/Zip Hays, Kansas 67601  
Contact Person M.D. Monroe  
Phone 913-628-8694

SE NE/4 NE ... Sec 30 Twp 7 S, Rge 17  East  West  
(location)

CONTRACTOR: License # 5665  
Name Pioneer Drig. Co., Inc.  
City/State 308 W. Mill Plainville, Kansas

4290 Ft North from Southeast Corner of Section  
330 Ft West from Southeast Corner of Section  
(Note: Locate well on Section Plat on reverse side)

Nearest lease or unit boundary line 330 feet.  
County Rooks

Lease Name Griffith Well# 12

Domestic well within 330 feet:  yes  no

Municipal well within one mile:  yes  no

Well Drilled For: Well Class: Type Equipment:  
 Oil  Swd  Infield  Mud Rotary  
 Gas  Inj  Pool Ext.  Air Rotary  
 OWWO  Expl  Wildcat  Cable

Depth to Bottom of fresh water 100 feet

Lowest usable water formation Dakota

Depth to Bottom of usable water 700 feet

Surface pipe by Alternate:  1  2

Surface pipe to be set Anhydrite (~1160) feet

Conductor pipe if any required 80 feet

Ground surface elevation 1790 feet MSL

This Authorization Expires 4-29-85

Approved By 10-29-84 *Re*

If OWWO: old well info as follows:

Operator .....  
Well Name .....  
Comp Date ..... Old Total Depth .....  
Projected Total Depth ..... feet  
Projected Formation at TD .....  
Expected Producing Formations .....


I certify that we will comply with K.S.A. 55-101, et seq., plus eventually plugging hole to K.C.C. specifications.

Date 10-28-84 Signature of Operator or Agent Jane Monroe Title Owner  
MHC/NOHE 10/29/84 Form C-1 4/84

**Must be filed with the K.C.C. five (5) days prior to commencing well  
This card void if drilling not started within six (6) months of date received by K.C.C.**

**Important procedures to follow:**

**A Regular Section of Land  
1 Mile = 5,280 Ft.**

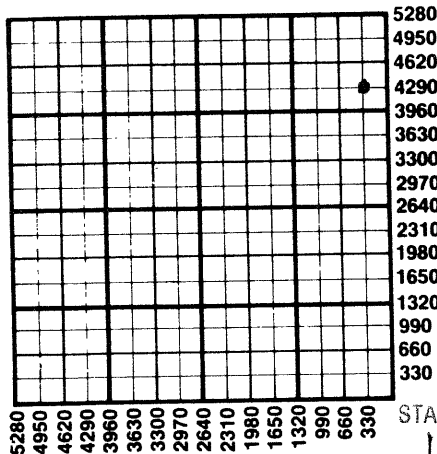

1. Notify District office before setting surface casing.
2. Set surface casing by circulating cement to the top.
3. File completion forms ACO-1 with K.C.C. within 90 days of well completion, following instructions on ACO-1, side 1, and including copies of wireline logs.
4. Notify District office 48 hours prior to old well workover or re-entry.
5. Prior to plugging, prepare a plugging plan, then obtain agreement from the appropriate district office for an approved plugging plan.
6. Submit plugging report (CP-4) to K.C.C. after plugging is completed.
7. Obtain an approved injection docket number before disposing of salt water.
8. Notify K.C.C. within 10 days when injection commences or terminates.
9. If an alternate 2 completion, cement in the production pipe from below any usable water to surface within 120 days of spud date.

RECEIVED  
STATE CORPORATION COMMISSION

10-29-84  
OCT 29 1984

**State Corporation Commission of Kansas  
Conservation Division  
200 Colorado Derby Building  
Wichita, Kansas 67202  
(316)263-3238**

CONSERVATION DIVISION  
Wichita, Kansas