

CARD MUST BE TYPED

State of Kansas

CARD MUST BE SIGNED

EFFECTIVE DATE . . . 8-9-26-05

NOTICE OF INTENTION TO DRILL HUGOTON INFILL

SGA - No

Starting Date . . . 10-01-05 . . . month . . . day . . . year

API Number 15 - 055.21883.00.00

OPERATOR: License # . . . 32390 . . . Name . . . HIGH PLAINS PRODUCTION, LLC . . . Address P. O. Box 228 . . . City/State/Zip . . . Savoy, TX. 75479 . . . Contact Person . . . Jim Fuller or Ron Osterbuhr . . . Phone . . . 903-965-5403 or 620-275-7888

IS SECTION C SW Sec. . . . 23 Twp. . . . 22 S, Rg. . . . 32 W . . . 1250' . . . Ft. from South Line of Section . . . 4030' . . . Ft. from East Line of Section

CONTRACTOR: License # . . . 5382 33375 . . . Name . . . Cheyenne Drilling, LP . . . City/State . . . Garden City, KS . . . Well Drilled as: X New Recompletion OWWO . . . Projected Total Depth . . . 2800 . . . feet . . . Formation . . . Chase Group

NOTE: Attach acreage attribution plat locating both Chase (Hugoton) wells . . . Total number of acres attributed to unit . . . 640

If OWWO or Recompletion: old well info as follows: . . . Operator . . . Well Name . . . Comp. Date . . . Old Total Depth

Nearest producing well from . . . same common source of supply . . . 2800 . . . feet . . . Nearest lease or unit boundary line . . . 1250 . . . feet . . . County . . . Finney . . . Lease Name . . . Riffel . . . Well # . . . 2-23 . . . Ground surface elevation . . . 2952 . . . feet MSL . . . Depth to bottom of fresh water . . . 260 . . . Depth to bottom of usable water . . . 1300 . . . Surface pipe by Alternate: . . . 1 2 X . . . Surface pipe planned to be set . . . 285' . . . Water Source for Drilled Operations: . . . DWR Permit #: . . . well . . . farm pond . . . X . . . other


I certify that well will comply with K.S.A. 55-101, et seq., plus eventually plugging hole to KCC specifications. . . . Date . . . 09-16-05 . . . Signature of Operator or Agent . . . James R. Fuller . . . Title member/manager . . .

For KCC Use: . . . Conductor Pipe Required . . . NONE . . . feet; Minimum Surface Pipe Required . . . 260 . . . feet per Alt. 2 . . . This Authorization Expires . . . 3-21-05 . . . Approved By . . . RFB 9-21-05 . . .

RECEIVED KANSAS CORPORATION COMMISSION SEP 21 2005 CONSERVATION DIVISION WICHITA, KS

Must be filed with K.C.C. five (5) days prior to commencing well This card void if drilling not started within six (6) months of date received by K.C.C.

A Regular Section of Land 1 Mile = 5,280 Ft.

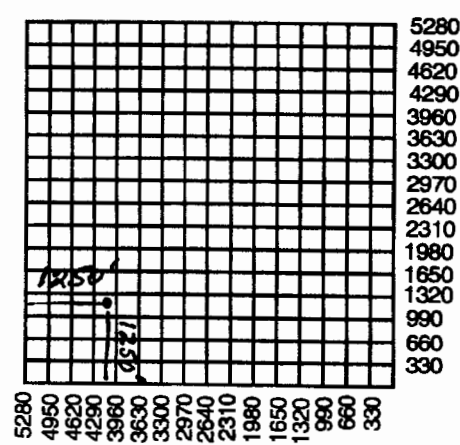

- Important procedures to follow: 1. Notify District office before setting surface casing. 2. Set surface casing by circulating cement to the top. 3. File completion forms ACO-1 with K.C.C. within 120 days of well spud date, following instructions on ACO-1, side 1, and including copies of wireline logs. 4. Notify District office 48 hours prior to old well workover or re-entry. 5. Submit plugging report (CP-4) to K.C.C. after plugging is completed. 6. If an alternate 2 completion, cement in the production pipe from below any useable water to surface within 120 days of spud date.

State Corporation Commission of Kansas Conservation Division 130 S. Market Room 2078 Wichita, Kansas 67202-1212 (316) 337-6231