

OWWO

For KCC Use: Effective Date: 11-22-05 District # SGA? Yes No

KANSAS CORPORATION COMMISSION OIL & GAS CONSERVATION DIVISION NOTICE OF INTENT TO DRILL

Form C-1 December 2002 Form must be Typed Form must be Signed All blanks must be Filled

Must be approved by KCC five (5) days prior to commencing well

Expected Spud Date 11 month 21 day 2005 year

Spot NE - NW - NW Sec. 3 Twp. 35S S. R. 31W East West 330 feet from N / S Line of Section 900 feet from E / W Line of Section Is SECTION Regular Irregular?

OPERATOR: License# 6113 Name: Landmark Resources, Inc. Address: 1616 S. Voss, Suite 150 City/State/Zip: Houston, TX 77057 Contact Person: Jeff Wood Phone: 713-254-4699

(Note: Locate well on the Section Plat on reverse side) County: Seward County, KS Lease Name: FLOYD OWWO Well #: 2 Field Name: ADOBE

CONTRACTOR: License# 30606 Name: MURFIN DRILLING CO., INC.

Is this a Prorated / Spaced Field? Yes No Target Formation(s): ARBUCKLE

Well Drilled For: Well Class: Type Equipment: Oil Enh Rec Infield Mud Rotary Gas Storage Pool Ext. Air Rotary OWO Disposal Wildcat Cable Seismic; # of Holes Other

Nearest Lease or unit boundary: 330 Ground Surface Elevation: 2717 G.L. feet MSL Water well within one-quarter mile: Yes No Public water supply well within one mile: Yes No Depth to bottom of fresh water: 300 Depth to bottom of usable water: 600 Surface Pipe by Alternate: 1 2 Length of Surface Pipe Planned to be set: SET @ 1626'

If OWWO: old well information as follows: Operator: MUSTANG OIL & GAS Well Name: FLOYD UNIT #2 (API# WAS 15-175-21493) Original Completion Date: 9/07/95 Original Total Depth: 5470

Projected Total Depth: 6500 Formation at Total Depth: ARBUCKLE

Directional, Deviated or Horizontal wellbore? Yes No If Yes, true vertical depth: Bottom Hole Location:

Water Source for Drilling Operations: Well Farm Pond Other: HAUL DWR Permit #:

KCC DKT #: NOV 14 2005

(Note: Apply for Permit with DWR) Will Cores be taken? Yes No If Yes, proposed zone:

Prorated & Spaced Hugoton

RECEIVED KANSAS CORPORATION COMMISSION NOV 14 2005 CONSERVATION DIVISION WICHITA KS

AFFIDAVIT

The undersigned hereby affirms that the drilling, completion and eventual plugging of this well will comply with K.S.A. 55 et. seq. It is agreed that the following minimum requirements will be met:

- 1. Notify the appropriate district office prior to spudding of well;
2. A copy of the approved notice of intent to drill shall be posted on each drilling rig;
3. The minimum amount of surface pipe as specified below shall be set by circulating cement to the top; in all cases surface pipe shall be set through all unconsolidated materials plus a minimum of 20 feet into the underlying formation.
4. If the well is dry hole, an agreement between the operator and the district office on plug length and placement is necessary prior to plugging;
5. The appropriate district office will be notified before well is either plugged or production casing is cemented in;
6. If an ALTERNATE II COMPLETION, production pipe shall be cemented from below any usable water to surface within 120 days of spud date. Or pursuant to Appendix "B" - Eastern Kansas surface casing order #133,891-C, which applies to the KCC District 3 area, alternate II cementing must be completed within 30 days of the spud date or the well shall be plugged. In all cases, NOTIFY district office prior to any cementing.

I hereby certify that the statements made herein are true and to the best of my knowledge and belief.

Date: 11/14/2005 Signature of Operator or Agent: Lissi L. Hartz Title: ASSISTANT TO THE PRESIDENT

For KCC Use ONLY API # 15 - 175-21493-00-01 Conductor pipe required NONE feet Minimum surface pipe required 1626 feet per Alt. 1 Approved by: RJP 11-17-05 This authorization expires: 5-17-06 (This authorization void if drilling not started within 6 months of approval date.) Spud date: Agent:

Remember to: - File Drill Pit Application (form CDP-1) with Intent to Drill; - File Completion Form ACO-1 within 120 days of spud date; - File acreage attribution plat according to field proration orders; - Notify appropriate district office 48 hours prior to workover or re-entry; - Submit plugging report (CP-4) after plugging is completed; - Obtain written approval before disposing or injecting salt water. - If this permit has expired (See: authorized expiration date) please check the box below and return to the address below. [] Well Not Drilled - Permit Expired Signature of Operator or Agent: Date:

3 35 314

IN ALL CASES PLOT THE INTENDED WELL ON THE PLAT BELOW

Plat of acreage attributable to a well in a prorated or spaced field

If the intended well is in a prorated or spaced field, please fully complete this side of the form. If the intended well is in a prorated or spaced field complete the plat below showing that the well will be properly located in relationship to other wells producing from the common source of supply. Please show all the wells and within 1 mile of the boundaries of the proposed acreage attribution unit for gas wells and within 1/2 mile of the boundaries of the proposed acreage attribution unit for oil wells.

API No. 15 - _____
 Operator: Landmark Resources, Inc. _____
 Lease: Floyd OWWO _____
 Well Number: 2 _____
 Field: ADOBE _____

Number of Acres attributable to well: _____
 QTR / QTR / QTR of acreage: NE - NW - NW


Location of Well: County: Seward County, KS
 _____ 330 feet from N / S Line of Section
 _____ 900 feet from E / W Line of Section
 Sec. 3 Twp. 35S S. R. 31W East West

Is Section: Regular or Irregular


If Section Is Irregular, locate well from nearest corner boundary.
 Section corner used: NE NW SE SW

PLAT

*(Show location of the well and shade attributable acreage for prorated or spaced wells.)
 (Show footage to the nearest lease or unit boundary line.)*

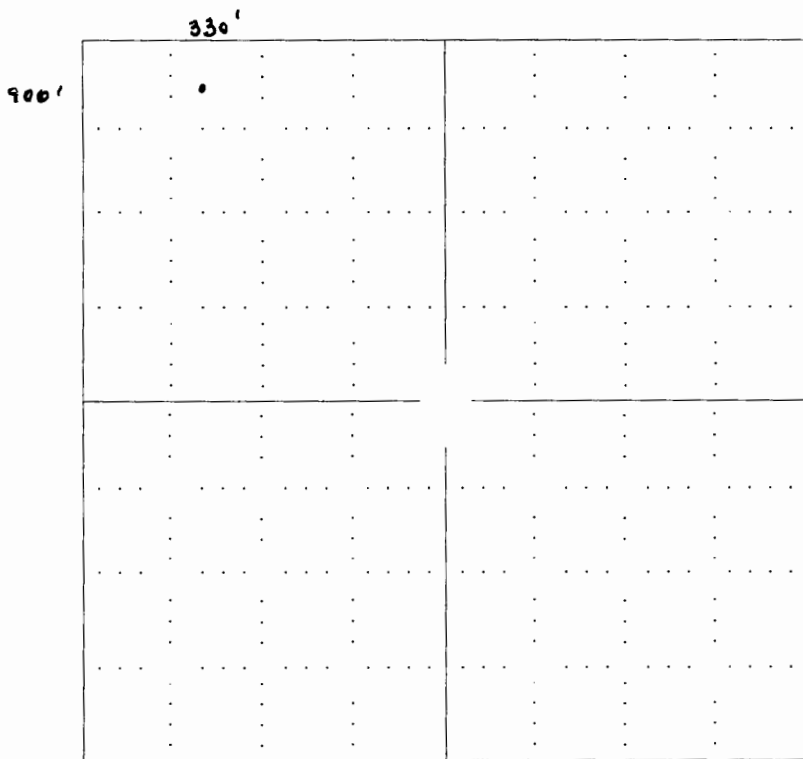

RECEIVED
 KANSAS CORPORATION COMMISSION
 NOV 14 2005
 CONSERVATION DIVISION
 WICHITA, KS

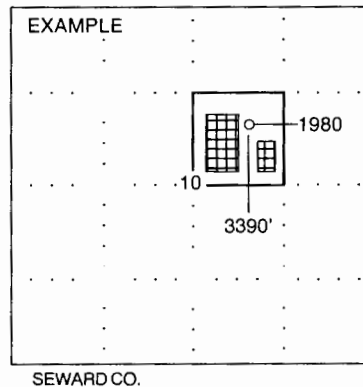

NOTE: In all cases locate the spot of the proposed drilling location.

In plotting the proposed location of the well, you must show:

1. The manner in which you are using the depicted plat by identifying section lines, i.e. 1 section, 1 section with 8 surrounding sections, 4 sections, etc.
2. The distance of the proposed drilling location from the section's south / north and east / west.
3. The distance to the nearest lease or unit boundary line.
4. If proposed location is located within a prorated or spaced field a certificate of acreage attribution plat must be attached: (CO-7 for oil wells; CG-8 for gas wells).