

KCC.DIST #1

CARD MUST BE TYPED

State of Kansas
NOTICE OF INTENTION TO DRILL
HUGOTON INFILL

CARD MUST BE SIGNED

SGA -NO

EFFECTIVE DATE . 11.26.05
Starting Date . September 15 2005
month day year

API Number 15 - 093-21774.00.00

OPERATOR: License # 4058
Name American Warrior, Inc.
Address PO Box 399
City/State/Zip Garden City, KS 67846
Contact Person Cecil O'Brate
Phone 620-275-9231

IS SECTION X REGULAR IRREGULAR
C NW Sec. 35 Twp. 21 S, Rg. 35 W
4030 Ft. from South Line of Section
4030 Ft. from East Line of Section

CONTRACTOR: License # 33375
Name Cheyenne Drilling, LP
City/State Garden City, KS 67846
Well Drilled as: X New Recompletion OWWO
Projected Total Depth 3100' feet
Formation Chase
If OWWO or Recompletion: old well info as follows:
Operator
Well Name
Comp. Date Old Total Depth

NOTE: Attach acreage attribution plat locating both Chase (Hugoton) wells
Total number of acres attributed to unit 640
Nearest producing well from same common source of supply 2710' feet
Nearest lease or unit boundary line 1250' feet
County KEARNEY
Lease Name O'Brate Well # 2
Ground surface elevation 3065' feet MSL
Depth to bottom of fresh water 180'
Depth to bottom of usable water 1050' 1000'
Surface pipe by Alternate: 1 2 X
Surface pipe planned to be set 300'
Water Source for Drilled Operations:
DWR Permit #: well farm pond X other

I certify that well will comply with K.S.A. 55-101, et seq., plus eventually plugging hole to KCC specifications.
Date 8-3-05 Signature of Operator or Agent Title Agent


For KCC Use:
Conductor Pipe Required NONE feet; Minimum Surface Pipe Required 200 feet per Alt. # 2
This Authorization Expires MAY 21, 2006 Approved By 230 NOV 21, 2005

9/95

Must be filed with K.C.C. five (5) days prior to commencing well
This card void if drilling not started within six (6) months of date received by K.C.C.

RECEIVED
AUG 04 2005
KCC WICHITA

A Regular Section of Land
1 Mile = 5,280 Ft.

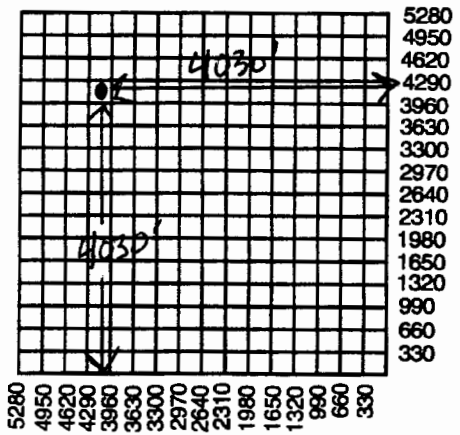

Important procedures to follow:

- 1. Notify District office before setting surface casing.
- 2. Set surface casing by circulating cement to the top.
- 3. File completion forms ACO-1 with K.C.C. within 120 days of well spud date, following instructions on ACO-1, side 1, and including copies of wireline logs.
- 4. Notify District office 48 hours prior to old well workover or re-entry.
- 5. Submit plugging report (CP-4) to K.C.C. after plugging is completed.
- 6. If an alternate 2 completion, cement in the production pipe from below any useable water to surface within 120 days of spud date.

RECEIVED
KANSAS CORPORATION COMMISSION

NOV 21 2005

CONSERVATION DIVISION
WICHITA, KS

State Corporation Commission of Kansas
Conservation Division
130 S. Market Room 2078
Wichita, Kansas 67202-1212
(316) 337-6231