

CARD MUST BE TYPED

State of Kansas

CARD MUST BE SIGNED

### NOTICE OF INTENTION TO DRILL

(see rules on reverse side)

Starting Date ..... 11 ..... 18 ..... 1986  
month day year

API Number 15— 121-26, 778-00-00  
NW SE X  
East

OPERATOR: License # ..... 3183

App C S 1/2 SE Sec. 6 Twp. 16 S, Rg. 22 West

Name ..... Harry Miller

Address ..... Route 1, Box 164

City/State/Zip ..... Wellsville, KS 66092

Contact Person ..... A.G. Glaze

Phone ..... 913.764.2625

700 ..... Ft. from South Line of Section  
1300 ..... Ft. from East Line of Section

(Note: Locate well on Section Plat on reverse side)

Nearest lease or unit boundary line ..... 1100 ..... feet

County ..... Miami

Lease Name ..... Miller Well # ..... 1

Ground surface elevation ..... na ..... feet MSL

Domestic well within 330 feet: ..... yes  no

Municipal well within one mile: ..... yes  no

Depth to bottom of fresh water ..... 75

Depth to bottom of usable water ..... 150

Surface pipe by Alternate: ..... 1 2

Surface pipe planned to be set ..... 20

Conductor pipe required

Projected Total Depth ..... 800 ..... feet

Formation

Well Drilled For: Well Class: Type Equipment:

Oil  SWD  Infill  Mud Rotary

Gas  Inj  Pool Ext.  Air Rotary

OWWO  Expl  Wildcat  Cable

If OWWO: old well info as follows:

Operator

Well Name

Comp Date Old Total Depth

I certify that well will comply with K.S.A. 55-101, et seq., plus eventually plugging hole to KCC specifications.

Date .. 11/17/86 .. Signature of Operator or Agent Elaine Durham Title .. as agent

For KCC Use:

Conductor Pipe Required ..... feet; Minimum Surface Pipe Required ..... 20 ..... feet per Alt. 43

This Authorization Expires ..... 5-17-87 ..... Approved By ..... 11-17-86


*[Handwritten signature]*

Must be filed with the K.C.C. five (5) days prior to commencing well  
 This card void if drilling not started within six (6) months of date received by K.C.C.

**Important procedures to follow:**

1. Notify District office before setting surface casing.
2. Set surface casing by circulating cement to the top.
3. File completion forms ACO-1 with K.C.C. within 90 days of well completion, following instructions on ACO-1, side 1, and including copies of wireline logs.
4. Notify District office 48 hours prior to old well workover or re-entry.
5. Prior to filing Intent, prepare a proposed plugging plan in case well is D & A, then obtain approval of plan when calling district office prior to setting surface pipe.
6. Submit plugging report (CP-4) to K. C. C. after plugging is completed.
7. Obtain an approved injection docket number before disposing of salt water.
8. Notify K.C.C. within 10 days when injection commences or terminates.
9. If an alternate 2 completion, cement in the production pipe from below any usable water to surface within 120 days of spud date.

**A Regular Section of Land  
 1 Mile = 5,280 Ft.**

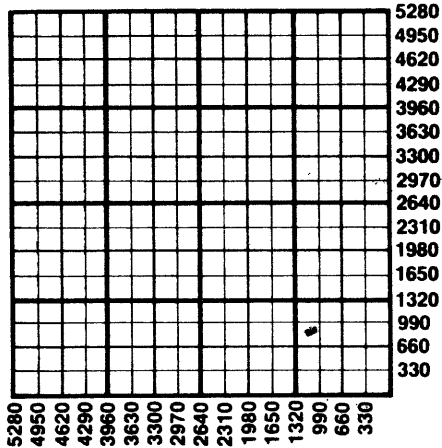

State Corporation Commission of Kansas  
 Conservation Division  
 200 Colorado Derby Building  
 Wichita, Kansas 67202  
 (316) 263-3238