
Kansas Corporation Commission Oil & Gas Conservation Division

WELL PLUGGING APPLICATION

Please TYPE Form and File ONE Copy

Form CP-1 September 2003 This Form must be Typed Form must be Signed All blanks must be Filled

API # 15 - 063-20,541 - 00 - 0	(Identifier Number of this well).	This must be listed for wells drille	d since 1967; if no API # was issued,
indicate original spud or completion date			le/_
Well Operator: FALCON EXPLORATION, IN	IC.	KCC License #: 50	316
Address: 155 N. MARKET, SUITE 1020		City: WICHITA	
State: KANSAS	Zip Code: 67202		262 - 1378
Lease: BECK	Well #: 2 'OWWO'	Sec. 25 Twp. 13	S. R. 30 East V West
NIA/ NIA/ NIA/	t Location / QQQQ County	GOVE	
4950 Feet (in exact footage) From	North / South (from neares		ection (Not Lease Line)
4950 Feet (in exact footage) From	East / West (from neares	st outside section corner) Line of S	ection (Not Lease Line)
Check One: Oil Well Gas Well GD 12912 (C 20 16		Nater Supply Well	
✓ SWD Docket # CD-12813 (C-20,46	ENHR Docket #	Otil	ner:
Conductor Casing Size:	Set at:		Sacks
Surface Casing Size: 8-5/8"	Set at: _190'	Cemented with: 150	Sacks
Production Casing Size: 5-1/2"	Set at: 4214	Cemented with: 140	Sacks
List (ALL) Perforations and Bridgeplug Sets: PERFS	: 2000-2054' (CEDAR HIL	LS)	
Elevation: 2877 (G.L. / K.B.) T.D.: 4720	PBTD: 4110 Anh	vdrite Depth: 2300-2330	
Condition of Well: Good Poor		الالالالالالالالالالالالالالالالالالال	Stone Corral Formation)
Proposed Method of Plugging (attach a separate page if a			10% GEL) DOWN THE CASING
CARRYING 500# HULLS; PUMP 25 SACK			
Is Well Log attached to this application as required?	✓ Yes No Is ACO-1 filed?	Yes No	
If not explain why?			
Plugging of this Well will be done in accordance with	n K.S.A. 55-101 <u>et.</u> <u>seq</u> . and the I	Rules and Regulations of the St	ate Corporation Commission.
List Name of Company Representative authorized to be	in charge of plugging operations		
RONALD S. SCHRAEDER		Phone: (316) 262	- 1378
Address: AS ABOVE		City / State:	
Plugging Contractor: ALLIED CEMENTING		KCC License #:	RECEIVE
, ,	ny Name)		(Contractor's)
			V 0 0 2005
		A.	ACC WICHITAS
Date: 9/30/05 Authorized Operator / Ag		Hamail (Signature)	ly
List Name of Company Representative authorized to be RONALD S. SCHRAEDER Address: AS ABOVE Plugging Contractor: ALLIED CEMENTING (Compand Address: Proposed Date and Hour of Plugging (if known?): UP Payment of the Plugging Fee (K.A.R. 82-3-118) will be	on APPROVAL BY K.C.C.	Phone: (316) 262 City / State: KCC License #: Phone: ()	- 1378 RFCENT

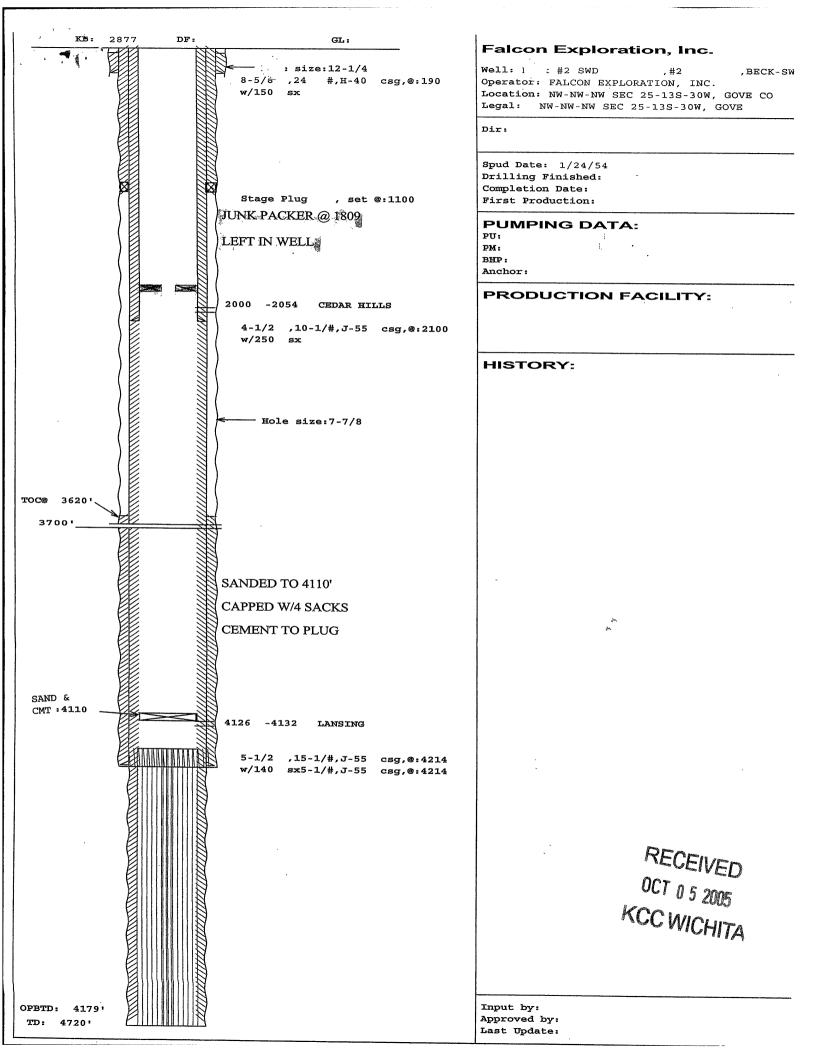

CORPORATION COMMISSION

Kathleen Sebelius, Governor

Brian J. Moline, Chair

Robert E. Krehbiel, Commissioner

Michael C. Moffet, Commissioner

NOTICE OF RECEIPT OF WELL PLUGGING APPLICATION (CP-1)

Falcon Exploration, Inc. 155 N. Market, Ste. 1020 Wichita, KS 67202

October 06, 2005

Re: BECK #2

API 15-063-20541-00-01

NWNWNW 25-13S-30W, 4950 FSL 4950 FEL

GOVE COUNTY, KANSAS

Dear Operator:

This letter is to notify you that the Conservation Division is in receipt of your plugging proposal, form CP-1, for the above-captioned well.

Your CP-1 has been reviewed by the Conservation Division central office for completeness and to verify license numbers. The plugging proposal will now be forwarded to the district office listed below for review of your proposed method of plugging.

Please contact the district office for approval of your proposed plugging method at least five (5) days before plugging the well, pursuant to K.A.R. 82-3-113 (b). If a workover pit will be used during the plugging of the well it must be permitted. A CDP-1 form must be filed and approved prior to the use of the pit.

The Conservation Division's review of form CP-1, either in the central or district office, does not include an inquiry into well ownership or the filing operator's legal right to plug the well.

This notice in no way constitutes authorization to plug the above-captioned well by persons not having legal rights of ownership or interest in the well. This notice is void after ninety (90) days from the above date.

Sincerely

David P. Williams

Production Supervisor

District: #4 2301 E. 13th Hays, KS 67601 (785) 625-0550