

CARD MUST BE SIGNED

Starting Date: 10 18 1984
month day year 2:40

OPERATOR: License # 6143
Name SOMERSET ENERGY, INC.
Address RR #4
City/State/Zip PAOLA, KANSAS 66071
Contact Person Lester Town
Phone (913) 294-2125

CONTRACTOR: License # 6142
Name TOWN OIL COMPANY
City/State PAOLA, KANSAS 66071

Well Drilled For:	Well Class:	Type Equipment:
☐ Oil ☐ Swd	☒ Infield	☒ Mud Rotary
☐ Gas ☒ Inj	☐ Pool Ext.	☐ Air Rotary
☐ OWWO ☐ Expl	☐ Wildcat	☐ Cable

If OWWO: old well info as follows:

Operator
Well Name
Comp Date Old Total Depth
Projected Total Depth 750 feet
Projected Formation at TD Bartlesville
Expected Producing Formations

I certify that we will comply with K.S.A. 55-101, et seq., plus eventually plugging hole to K.C.C. specifications.

API Number 15- 121-26,389-00-00

NE SE NW Sec 17 Twp 16 S, Rge 24 ☒ East
(location) ☐ West

.....364.0..... Ft North from Southeast Corner of Section
266.0..... Ft West from Southeast Corner of Section
 (Note: Locate well on Section Plat on reverse side)

Nearest lease or unit boundary line 20 feet.
County MIAMI

Lease Name BARKIS Well# AW-4

Domestic well within 330 feet : ☐ yes ☒ no

Municipal well within one mile : ☐ yes ☒ no


Depth to Bottom of fresh water None 29 feet
 Lowest usable water formation
 Depth to Bottom of usable water 300 feet
 Surface pipe by Alternate : 1 ☐ 2 ☒
 Surface pipe to be set 20 feet
 Conductor pipe if any required None feet
 Ground surface elevation feet MSL
 This Authorization Expires 4-18-85
 Approved By 10-18-84 

Date 10-18-84 Signature of Operator or Agent *Frank P. ...* Title Agent

Form C-1 4/84

SEPT 1984
DIVISION OF CONSERVATION
Must be filed with the K.C.C. five (5) days prior to commencing well
This card void if drilling not started within six (6) months of date received by K.C.C.

10-18-84
OCT 18 1984
STATE CORPORATION COMMISSION
A Regular Section
1 Mile = 5,280 Ft.

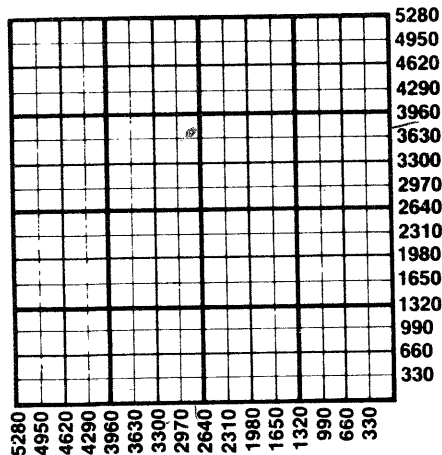

Important procedures to follow :

1. Notify District office before setting surface casing.
2. Set surface casing by circulating cement to the top.
3. File completion forms ACO-1 with K.C.C. within 90 days of well completion, following instructions on ACO-1, side 1, and including copies of wireline logs.
4. Notify District office 48 hours prior to old well workover or re-entry.
5. Prior to plugging, prepare a plugging plan, then obtain agreement from the appropriate district office for an approved plugging plan.
6. Submit plugging report (CP-4) to K.C.C. after plugging is completed.
7. Obtain an approved injection docket number before disposing of salt water.
8. Notify K.C.C. within 10 days when injection commences or terminates.
9. If an alternate 2 completion, cement in the production pipe from below any usable water to surface within 120 days of spud date.

State Corporation Commission of Kansas
Conservation Division
200 Colorado Derby Building
Wichita, Kansas 67202
(316) 263-3238