State of Kansas

NOTICE OF INTENTION TO DRILL


(see rules on reverse side)

CARD MUST BE SIGNED

CORRECTION 11-6-85

Starting DateNov.	4 1985	. API Number 15— 121-26,617 \ \ \ \ \ \ \ \ \ \ \ \ \ \ \ \ \ \ \
month		X East
OPERATOR: License #824	p. C. S2. NW SW sec. 14. Twp. 17. s, Rg 21 West	
Name Stanton Explora	tions, Inc.	
Address Box 392		
City/State/Zip Osawatomie		(Note: Locate well on Section Plat on reverse side)
Contact Person Steve Co	ttrell	•
Phone 913 294 4204 or 294 5500		. Nearest lease or unit boundary line330feet
CONTRACTOR: License #	6251	. CountyMiami
Name Ballou Oil Wel	1 Services	. Lease NameBlack Well #B-4
City/State Route 5, Box	159, Paola, KS 6670	1 Ground surface elevation
Well Drilled For: We	ell Class: Type Equipmen	
X Oil SWD X	InfieldX Mud Rotary	Municipal well within one mile:yes Xno
Gas Inj	Pool Ext Air Rotary	Surface pipe by Alternate: 1 2 X
OWWO Expl	_ Wildcat Cable	Depth to bottom of fresh water43
If OWWO: old well info as follows:		Depth to bottom of usable water200
Operator		. Surface pipe planned to be set20
Well Name		Projected Total Depth
Comp Date Old To	otal Depth	
I certify that well will comply with K.S.A. 55-101, et seq., plus eventually plugging hole to KCC specifications. NEWWSW 2150 FSC		
cementing will be done immediately upon setting production casing. FLAS: #7.6 3990 FEL		
Date		
For KCC Use:		
Conductor Pipe Requiredfeet: Minimum Surface Pipe Requiredfeet per Alt. 1 2		
This Authorization Expires 1-31-86 Approved By 7-31-85		

Must be filed with the K.C.C. five (5) days prior to commencing well This card void if drilling not started within six (6) months of date received by K.C.C.

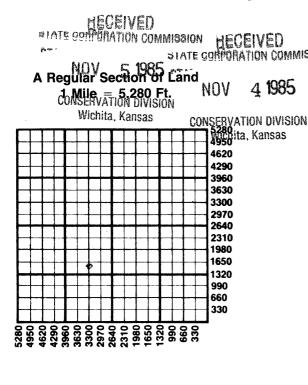

Important procedures to follow:

- DEVELVEL 1. Notify District office before setting surface casing.
 - 2. Set surface casing by circulating cement to the top.
 - File completion forms ACO-1 with K.C.C. within 90 days of well completion, following instructions on ACO-1, side 1, and including copies of wireline logs.
 - 4. Notify District office 48 hours prior to old well workover or re-entry.
 - 5. Prior to filing Intent, prepare a proposed plugging plan in case well is D & A, then obtain approval of plan when calling district office prior to setting surface pipe.
 - 6. Submit plugging report (CP-4) to K.C.C. after plugging is completed.
 - Obtain an approved injection docket number before disposing of salt water.
 - 8. Notify K.C.C. within 10 days when injection commences or terminates.
 - 9. If an alternate 2 completion, cement in the production pipe from below any usable water to surface within 120 days of spud date.

State Corporation Commission of Kansas Conservation Division 200 Colorado Derby Building Wichita, Kansas 67202 (316) 263-3238