

CARD MUST BE TYPED

State of Kansas

CARD MUST BE SIGNED

NOTICE OF INTENTION TO DRILL

(see rules on reverse side)

Starting Date August 13, 1985
month day year

API Number 15— 121-26,626 - 00 - 00

OPERATOR: License # 8246

Name Stanton Explorations, Inc.

Address Box 392

City/State/Zip Osawatomie, Kansas 66064

Contact Person Steve Cottrell

Phone 913.294.4204 or 5500

CONTRACTOR: License # 6251

Name Ballou Oil Well Services

City/State R. 5, Box 159, Paola, KS 66701

Well Drilled For: Well Class: Type Equipment:

Oil SWD Infield Mud Rotary
 Gas Inj Pool Ext. Air Rotary
 OWWO Expl Wildcat Cable

IF OWWO: old well info as follows:

Operator
Well Name
Comp Date Old Total Depth

I certify that well will comply with K.S.A. 55-101, et seq., plus eventually plugging hole to KCC specifications.

_____ Alternate 3 cementing will be done immediately upon setting production casing.

Date 8/12/85 Signature of Operator or Agent Edna Barkham Title As agent

RCA-BKONE

For KCC Use:

Conductor Pipe Required feet: Minimum Surface Pipe Required feet per Alt. 1 2 3


This Authorization Expires 2-12-86 Approved By 8-12-85 *RC*

UW 50 SE Sec 14... Twp 17... S, Rg... 21...
1100 Ft. from South Line of Section
5110 Ft. from East Line of Section
(Note: Locate well on Section Plat on reverse side)

Nearest lease or unit boundary line 170 feet
County Miami
Lease Name Black Well # A-3
Ground surface elevation feet MSL
Domestic well within 330 feet: ___ yes no
Municipal well within one mile: ___ yes no
Surface pipe by Alternate: 1 ___ 2 3 ___
Depth to bottom of fresh water 43
Depth to bottom of usable water 200
Surface pipe planned to be set 20
Projected Total Depth 650 feet
Formation Peru - Squirrel

Must be filed with the K.C.C. five (5) days prior to commencing well
This card void if drilling not started within six (6) months of date received by K.C.C.

RECEIVED
STATE CORPORATION COMMISSION
08-12-85
AUG 12 1985
A Regular Section of Land
1 Mile = 5 280 Ft.
CONSERVATION DIVISION
Wichita, Kansas

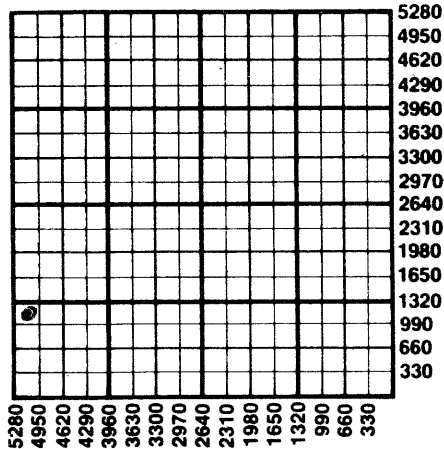

Important procedures to follow:

1. Notify District office before setting surface casing.
2. Set surface casing by circulating cement to the top.
3. File completion forms ACO-1 with K.C.C. within 90 days of well completion, following instructions on ACO-1, side 1, and including copies of wireline logs.
4. Notify District office 48 hours prior to old well workover or re-entry.
5. Prior to filing Intent, prepare a proposed plugging plan in case well is D & A, then obtain approval of plan when calling district office prior to setting surface pipe.
6. Submit plugging report (CP-4) to K.C.C. after plugging is completed.
7. Obtain an approved injection docket number before disposing of salt water.
8. Notify K.C.C. within 10 days when injection commences or terminates.
9. If an alternate 2 completion, cement in the production pipe from below any usable water to surface within 120 days of spud date.

State Corporation Commission of Kansas
Conservation Division
200 Colorado Derby Building
Wichita, Kansas 67202
(316) 263-3238