

15-181-09039-00-00


Corp. Comm.  
Form CP-4

STATE OF KANSAS  
STATE CORPORATION COMMISSION

Give All Information Completely  
Make Required Affidavit  
Mail or Deliver Report to:  
Conservation Division  
State Corporation Commission  
211 No. Broadway  
Wichita, Kansas

WELL PLUGGING RECORD

NORTH

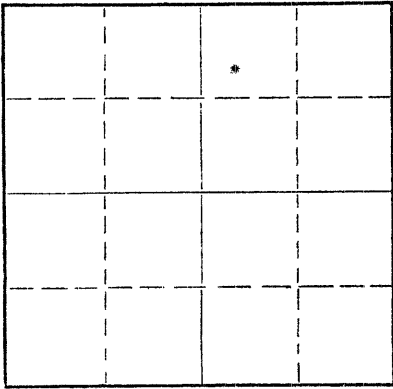

Locate well correctly on above  
Section Plat

Sherman County, Sec. 10 Twp. 6S Rge. 37 (E) W (W)

Location as "NE/CNW/SW" or footage from lines W/2 NW NE

Lease Owner Phillips Petroleum Company

Lease Name Ilanos Well No. 1

Office Address Box 287, Great Bend, Kansas

Character of Well (completed as Oil, Gas or Dry Hole) Oil

Date well completed May 19 1958

Application for plugging filed April 18 1968

Application for plugging approved April 19 1968

Plugging commenced May 21 1968

Plugging completed May 23 1968

Reason for abandonment of well or producing formation Casing leaks - unprofitable to repair

If a producing well is abandoned, date of last production 3-16-68 19

Was permission obtained from the Conservation Division or its agents before plugging was commenced? Yes

Name of Conservation Agent who supervised plugging of this well W. L. Nichols

Producing formation Cherokee Depth to top 4718' Bottom 4954' Total Depth of Well 4960' Feet

Show depth and thickness of all water, oil and gas formations.

OIL, GAS OR WATER RECORDS

CASING RECORD

FORMATION	CONTENT	FROM	TO	SIZE	PUT IN	PULLED OUT
				NR on surface casing		None
				4 1/2"	5017'	None

Describe in detail the manner in which the well was plugged, indicating where the mud fluid was placed and the method or methods used in introducing it into the hole. If cement or other plugs were used, state the character of same and depth placed, from \_\_\_\_\_ feet to \_\_\_\_\_ feet for each plug set.

Dumped rock & 2 sx cement from 4960' to 4750'. Drove wood plug to 1650', 20' rock 1650' to 1630', spotted 2 sx cement 1630' to 1605'. Top of plug 5-22-68 @ 1616'. Cemented 4 1/2" csg to top w/6 yards Redi-Mix. Plugging completed 10:30 AM, 5-22-68.

RECEIVED  
STATE CORPORATION COMMISSION  
MAY 28 1968 5-28-68  
CONSERVATION DIVISION  
Wichita, Kansas

(If additional description is necessary, use BACK of this sheet)

Name of Plugging Contractor Brown Bros. Well Service

Address Plainville, Kansas

STATE OF Kansas, COUNTY OF Barton, ss.

A. T. Slagle, Dist. Supt. (employee of owner) or (owner or operator) of the above-described well, being first duly sworn on oath, says: That I have knowledge of the facts, statements, and matters herein contained and the log of the above-described well as filed and that the same are true and correct. So help me God.

(Signature) A.T. Slagle

Box 287, Great Bend, Kansas  
(Address)

SUBSCRIBED AND SWORN TO before me this 27th day of May, 19 68

My commission expires 10-27-69

Notary Public.



15-181-05039-00-00

EXPLORATION RECORD

Lease Llanos

Well 1

Formation Name	Top	Base	Remarks
NO FORMATION RECORD AVAILABLE. DRILLED AS STRAT HOLE BY GEOLOGICAL DEPARTMENT.			
FORMATION TOPS - Schlumberger			
Ft. Hays	1545		
Base Ft. Hays	1605		
Anhydrite	3097		
Base Anhydrite	3132		
Admire	3778		
Maple Hill	3938		
Howard	4066		
Topeka	4089		
Heebner	4229		
Toronto	4268		
Lansing-Kansas City	4286		
Drum	4421		
Base-Kansas City	4566		
Marmaton	4576		
Cherokee	4718		
Mississippian	4954		
Total Depth	5001		
PBTB	4960		

RECEIVED  
STATE CORPORATION COMMISSION  
MAY 28 1968  
CONSERVATION DIVISION  
Wichita, Kansas