


STATE OF KANSAS
STATE CORPORATION COMMISSION

WELL PLUGGING RECORD

15-181-20020-00-00

Give All Information Completely
Make Required Affidavit
Mail or Deliver Report to
Conservation Division
State Corporation Comm.
245 North Water
Wichita, KS 67202

Sherman County, Sec. 19 Twp. 6S Rge. 37 ~~XX~~W
Location as "NE/CNW $\frac{1}{4}$ /SW $\frac{1}{4}$ " or footage from lines
NE SE
Lease Owner Energy Reserves Group, Inc.
Lease Name QUERY Well No. 1
Office Address 1022 Hoover Street, Great Bend, KS 67530
Character of Well (Completed as Oil, Gas or Dry Hole)
Dry Hole

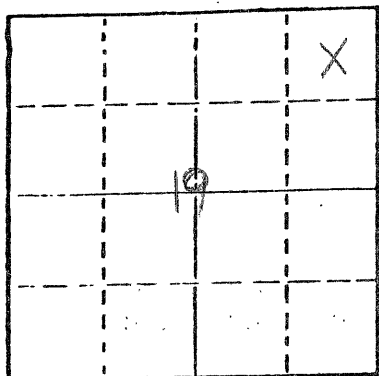

Locate well correctly on above Section Plot

Date Well completed July 27 1976
Application for plugging filed (verbally) July 27 1976
Application for plugging approved (verbally) July 27 1976
Plugging commenced July 27 1976
Plugging completed July 27 1976
Reason for abandonment of well or producing formation No commercial quantity of oil or gas encountered.
If a producing well is abandoned, date of last production 19

Was permission obtained from the Conservation Division or its agents before plugging was commenced? Yes

Name of Conservation Agent who supervised plugging of this well Leo Massey
Producing formation _____ Depth to top _____ Bottom _____ Total Depth of Well 5090'
Show depth and thickness of all water, oil and gas formations.

OIL, GAS OR WATER RECORDS

CASING RECORD

FORMATION	CONTENT	FROM	TO	SIZE	PUT IN	PULLED OUT
				8-5/8"	354'	None

Describe in detail the manner in which the well was plugged, indicating where the mud fluid was placed and the method or methods used in introducing it into the hold. If cement or other plugs were used, state the character of same and depth placed, from _____ feet to _____ feet for each plug set.

RECEIVED
STATE CORPORATION COMMISSION

1st plug set @2000' with 70 sx.
2nd plug set @240' with 20 sx.
3rd plug set @40' with 10 sx.
Plug was down @ 1:00 p.m. on July 27, 1976
State Plugging: Leo Massey

AUG 09 1976

8-9-76
CONSERVATION DIVISION
Wichita, Kansas

(If additional description is necessary, use BACK of this sheet)

Name of Plugging Contractor Abercrombie Drilling, Inc.
801 Union Center, Wichita, Kansas 67202

STATE OF KANSAS COUNTY OF SEDGWICK ss.


Jerry A. Langrehr, Executive Vice President (employee of owner) or (owner or operator) of the above-described well, being first duly sworn on oath, says: That I have knowledge of the facts, statements, and matters herein contained and the log of the above-described well as filed and that the same are true and correct. So help me God.

(Signature) Jerry A. Langrehr
801 Union Center, Wichita, Kansas 67202
(Address)

SUBSCRIBED AND SWORN TO before me this 6th day of August, 1976.

October 5, 1976

Mildred Saxton
Mildred Saxton Notary Public.

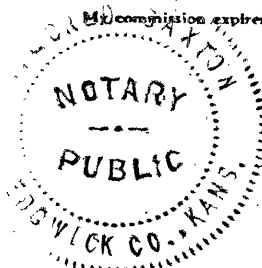

CONTRACTOR'S WELL LOG

15-181-20020-00-00

OPERATOR: Energy Reserves Group, Inc.
 CONTRACTOR: Abercrombie Drilling, Inc.
 WELL NAME: QUERY #1
 LOCATION: NE ~~SE~~ Section 19-6S-37W
 Sherman County, Kansas
 SPUD DATE: July 14, 1976
 COMPLETION DATE: July 27, 1976

0	360	Surface soil and sand
360	2097	Shale
2097	2788	Shale & Sand
2788	3440	Shale
3440	3798	Shale & Lime
3798	4045	Lime & Shale
4045	5090	Lime
	5090	Rotary Total Depth

On surface cut 360' 12-1/4" surface hole. Ran 8 jts. new 8-5/8" casing 24#, tallied 345.96' set @ 354' with 200 sx. 50/50 Posmix, 2% gel, 3% ca. cl. followed with 50 sx. portland cement - 2% ca. cl. Plug down @ 1:45 a.m. this morning. Slope 1 1/2° at 360'. Cement circulated.

TD 5090'. Plugged with 70 sx. - 200', 20 sx. - 240', 10 sx. - 40'. Cement was 50/50 Posmix, 6% gel. - Plug down @ 1:00 p.m. State Plugger - Leo Massey (7-27-76)

SAMPLE TOPS:

Anhydrite	3105' (+356)	Toronto	4304' (-843)
B/Anhydrite	3143' (+318)	Lansing	4321' (-860)
Neva	3641' (-180)	B/KC	4596' (-1135)
Foraker	3794' (-333)	Cherokee Shale	4767' (-1306)
Heebner	4624' (-1803)	Morrow Sand	4945' (-1484)

RECEIVED
STATE CORPORATION COMMISSION

AUG 09 1976

8-9-76
CONSERVATION DIVISION
Wichita, Kansas

STATE OF KANSAS }
 COUNTY OF SEDGWICK } SS

Jerry A. Langrehr, Executive Vice President of Abercrombie Drilling, Inc., does hereby state that the above and foregoing is a true and correct copy of the log of the QUERY #1, NE ~~SE~~ Section 19-6S-37W, Sherman County, Kansas.

ABERCROMBIE DRILLING, INC.

By: Jerry A. Langrehr
 Jerry A. Langrehr, Exec. V. P.

Subscribed and sworn to before me, a Notary Public, in and for the aforesaid county and state as of this 6th day of August, 1976.

Mildred Saxton
 Mildred Saxton - Notary Public

My Commission Expires: October 5, 1976



COPY