

This form shall be filed in duplicate with the Kansas Corporation Commission, 200 Colorado Derby Building, Wichita, Kansas 67202, within ten days after the completion of the well, regardless of how the well was completed.

Attach separate letter of request if the information is to be held confidential. If confidential, only file one copy. Information on side one will be of public record and side two will then be held confidential.

Circle one: Oil, Gas, Dry, SWD, OWWO, Injection. Type and complete ALL sections. Applications must be filed for dual completion, commingling, SWD and injection, T.A.

Attach wireline logs (i.e. electrical log, sonic log, gamma ray neutron log, etc.). KCC # (316) 263-3238. (Rules 82-2-105 & 82-2-125)

OPERATOR Colorado Crude Explorations, Inc.

API NO. 15-163-21,282 00-00

ADDRESS 12395 W. 53rd Avenue, Suite 102
Arvada, CO 80002

COUNTY Rooks
FIELD Riffe

**CONTACT PERSON Harry W. Chabin
PHONE (303) 423-2500

PROD. FORMATION Arbuckle
LEASE Walker


PURCHASER CRA Inc.
ADDRESS P. O. Box 7305
Kansas City, MO 64116

WELL NO. 2
WELL LOCATION NW SW SE

DRILLING Ranger Drilling Co., Inc.
CONTRACTOR
ADDRESS P. O. Box 717
Hays, KS 67601

330 Ft. from N Line and
330 Ft. from W Line of
the SE SEC. 19 TWP. 7S RGE. 17W

WELL PLAT

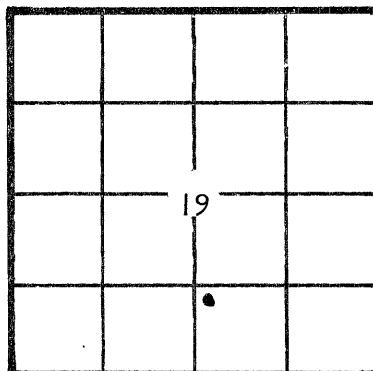

KCC
KGS
(Office Use)

PLUGGING
CONTRACTOR
ADDRESS

TOTAL DEPTH 3234' PBTD

SPUD DATE 3/29/81 DATE COMPLETED 4/5/81

ELEV: GR 1750' DF 1753' KB 1755'

DRILLED WITH (CABLE) (ROTARY) (AIR) TOOLS

Amount of surface pipe set and cemented 13 3/8" @ 80'
8 5/8" @ 1112'. DV Tool Used?

AFFIDAVIT

STATE OF Colorado, COUNTY OF Jefferson SS, I,

Harry W. Chabin OF LAWFUL AGE, BEING FIRST DULY SWORN UPON HIS OATH,

DEPOSES THAT HE IS President (FOR)(OF) Colorado Crude Explorations, Inc.

OPERATOR OF THE Walker LEASE, AND IS DULY AUTHORIZED TO MAKE

THIS AFFIDAVIT FOR AND ON THE BEHALF OF SAID OPERATOR, THAT WELL NO. 2 ON

SAID LEASE HAS BEEN COMPLETED AS OF THE 5th DAY OF April, 19 81, AND THAT

ALL INFORMATION CONTAINED HEREIN WITH RESPECT TO SAID WELL IS TRUE AND CORRECT.

FURTHER AFFIANT SAITH COMMISSION

RECEIVED
STATE CORPORATION COMMISSION
APR 12 1982 4-12-82
CONSERVATION DIVISION
WICHITA, KANSAS

SUBSCRIBED AND SWORN BEFORE ME THIS 6th DAY OF April, 19 82.

(S) Harry W. Chabin
Suzanne Y. Nicholls
NOTARY PUBLIC

MY COMMISSION EXPIRES: June 19, 1983

**The person who can be reached by phone regarding any questions concerning this information. Within 45 days of completion, a witnessed initial test by the Commission is required if the well produces more than 25 BOPD or is located in a Basic Order Pool.

SIDE TWO

WELL LOG

Show all important zones of porosity and contents thereof; cored intervals, and all drill-stem tests, including depth interval tested, cushion used, time tool open, flowing and shut-in pressures, and recoveries.

SHOW GEOLOGICAL MARKERS, LOGS RUN, OR OTHER DESCRIPTIVE INFORMATION.

FORMATION DESCRIPTION, CONTENTS, ETC.	TOP	BOTTOM	NAME	DEPTH
Anhydrite	1107'			
Lansing	2938'			
Arbuckle	3219'			
No Drill Stem Test				

Report of all strings set — surface, intermediate, production, etc. **CASING RECORD** (New) or (Used)

Purpose of string	Size hole drilled	Size casing set in O.D.	Weight lbs/ft.	Setting depth	Type cement	Sacks	Type and percent additives
Conductor		13 3/8"	48	80'	Common	100	ASC
Surface		8 5/8"	24	1117'	Common	450	ASC
Production		5 1/2"	14	3220'	Common	250	ASC

LINER RECORD

Top, ft	Bottom ft	Sacks cement

PERFORATION RECORD

Shots per ft.	Size & type	Depth interval
None - Open hole completion		

TUBING RECORD

Size	Setting depth	Packer set at
2 3/8"	3219'	None

ACID, FRACTURE, SHOT, CEMENT SQUEEZE RECORD

Amount and kind of material used	Depth interval treated
None - Open hole completion	

Date of first production 5/15/81	Producing method (flowing, pumping, gas lift, etc.) Pumping	Gravity 24.5
-------------------------------------	--	-----------------

RATE OF PRODUCTION PER 24 HOURS	Oil 50 bbls.	Gas MCF	Water %	Gas-oil ratio	CFPB
--	-----------------	------------	------------	---------------	------

Disposition of gas (vented, used on lease or sold)

Perforations None