

This form shall be filed in duplicate with the Kansas Corporation Commission, 200 Colorado Derby Building, Wichita, Kansas 67202, within ten days after the completion of the well, regardless of how the well was completed.

Attach separate letter of request if the information is to be held confidential. If confidential, only file one copy. Information on side one will be of public record and side two will then be held confidential.

Circle one: Oil, Gas, Dry, SWD, OWVO, Injection. Type and complete ALL sections. Applications must be filed for dual completion, commingling, SWD and injection, T.A.

Attach wireline logs (i.e. electrical log, sonic log, gamma ray neutron log, etc.). KCC # (316) 263-3238. (Rules 82-2-105 & 82-2-125)

OPERATOR C. C. & S. Oil Operations, Inc.
ADDRESS 12 Northridge Plaza
Hays, Ks. 67601

API NO. 15-163-21,508 -00-00
COUNTY Rooks
FIELD Riffe Ext.

**CONTACT PERSON Daniel Schippers
PHONE (913) 628-3284

PROD. FORMATION Arbuckle
LEASE Hutton


PURCHASER CRA, Inc.
ADDRESS P. O. Box 7305
Kansas City, Mo. 64114

WELL NO. 2
WELL LOCATION NW NE SW

DRILLING Emphasis Oil Operations
CONTRACTOR P. O. Box 506
ADDRESS Russell, ks. 67665

660 Ft. from East Line and
660 Ft. from North Line of
the SW 1/4 SEC. 19 TWP. 7 RGE. 17 W

PLUGGING
CONTRACTOR
ADDRESS

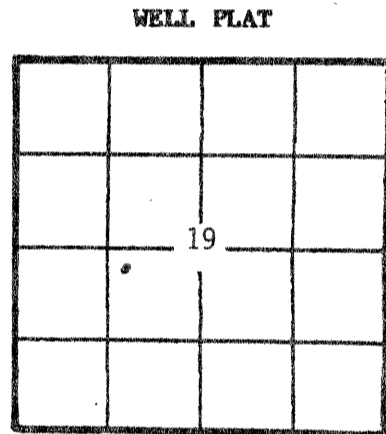

KCC
KGS
(Office Use)

TOTAL DEPTH 3238' PBD
SPUD DATE 12/16/81 DATE COMPLETED 12/24/81
ELEV: GR 1742 DF 1745 KB 1747

DRILLED WITH (CABLE) (ROTARY) (AIR) TOOLS
Amount of surface pipe set and cemented Conductor 105'
Surface 1173' DV Tool Used? NO

AFFIDAVIT

STATE OF KANSAS, COUNTY OF ELLIS SS, I,

Daniel F. Schippers OF LAWFUL AGE, BEING FIRST DULY SWORN UPON HIS OATH,
DEPOSES THAT HE IS Controller () (OF) C. C. & S. Oil Operations, Inc.

OPERATOR OF THE Hutton LEASE, AND IS DULY AUTHORIZED TO MAKE


THIS AFFIDAVIT FOR AND ON THE BEHALF OF SAID OPERATOR, THAT WELL NO. 2 ON
SAID LEASE HAS BEEN COMPLETED AS OF THE 2nd DAY OF February, 19 82, AND THAT

ALL INFORMATION ENTERED HEREIN WITH RESPECT TO SAID WELL IS TRUE AND CORRECT.

FURTHER AFFIANT SAITH NOT.

REC'D 2-11-82

(s) Daniel F. Schippers

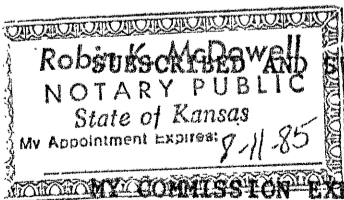

SUBSCRIBED AND SWORN BEFORE ME THIS 10th DAY OF February, 19 82

Robert K. McDowell
NOTARY PUBLIC

MY COMMISSION EXPIRES: 8-11-85

**The person who can be reached by phone regarding any questions concerning this information. Within 45 days of completion, a witnessed initial test by the Commission is required if the well produces more than 25 BOPD or is located in a Basic Order Pool.