

CARD MUST BE TYPED

State of Kansas
NOTICE OF INTENTION TO DRILL

CARD MUST BE SIGNED

(see rules on reverse side)

CORRECTED INTENT - CHANGE IN OPERATOR.

Starting Date: 06 30 85
month day year

API Number 15- ~~163-22,715~~ ~~0000~~

* OPERATOR: License # 8932

apr. C SE Sec 19 Twp 7 S, Rge 17
(location) East West

Name Apache Corporation

Address 1700 Lincoln, St. 4900

City/State/Zip Denver, CO 80202

Contact Person Ed Martin

Phone 303-831-6586

1320 Ft North from Southeast Corner of Section

1485 Ft West from Southeast Corner of Section

(Note: Locate well on Section Plat on reverse side)

CONTRACTOR: License # 6033

Name Murfin Drilling Company

City/State Wichita, KS

Nearest lease or unit boundary line 165 feet.

County Rooks

Lease Name Walker Well# 9-SWD

Domestic well within 330 feet: yes no

Municipal well within one mile: yes no

Well Drilled For: Well Class: Type Equipment:

Oil XSwd Infield Mud Rotary

Gas Inj Pool Ext. Air Rotary

OWWO Expl Wildcat Cable

Depth to Bottom of fresh water feet

Lowest usable water formation Dakota feet

Depth to Bottom of usable water 1100' feet

Surface pipe by Alternate: 1 2

Surface pipe to be set 1250' feet

Conductor pipe if any required 40' feet

Ground surface elevation 1752' feet MSL

This Authorization Expires 12-28-85

Approved By 016-0-6-28-85 PC# 8-19-85

If OWWO: old well info as follows:

Operator

Well Name

Comp Date Old Total Depth

Projected Total Depth 3600 feet

Projected Formation at TD Reagan & Lower Arbuckle

Expected Producing Formations Reagan Sand

I certify that we will comply with K.S.A. 55-101, et seq., plus eventually plugging hole to K.C.C. specifications. * WAS: MURFIN DRILLING CO.

Date 6-27-85 Signature of Operator or Agent

J. E. Goss Title Ass't. Drlg. Mgr.

J. E. Goss, Agent for Operator

RECEIVED
STATE CORPORATION COMMISSION
KANSAS

AUG 19 1985

REGISTRATION DIVISION
Conservation Division of Land
With Well Log 2280 Ft.

Must be filed with the K.C.C. five (5) days prior to commencing well
This card void if drilling not started within six (6) months of date received by K.C.C.


RECEIVED
STATE CORPORATION COMMISSION
KANSAS

JUN 28 1985

REGISTRATION DIVISION
Conservation Division
Wichita, Kansas

Important procedures to follow :

1. Notify District office before setting surface casing.
2. Set surface casing by circulating cement to the top.
3. File completion forms ACO-1 with K.C.C. within 90 days of well completion, following instructions on ACO-1, side 1, and including copies of wireline logs.
4. Notify District office 48 hours prior to old well workover or re-entry.
5. Prior to plugging, prepare a plugging plan, then obtain agreement from the appropriate district office for an approved plugging plan.
6. Submit plugging report (CP-4) to K.C.C. after plugging is completed.
7. Obtain an approved injection docket number before disposing of salt water.
8. Notify K.C.C. within 10 days when injection commences or terminates.
9. If an alternate 2 completion, cement in the production pipe from below any usable water to surface within 120 days of spud date.

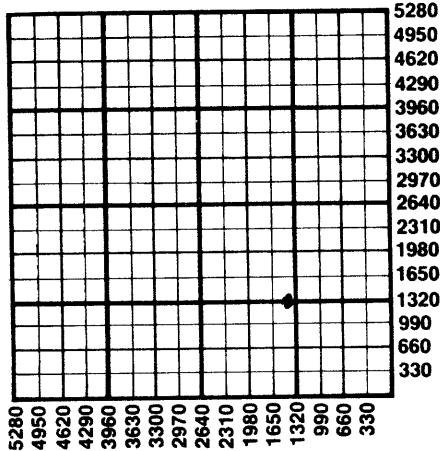

12

State Corporation Commission of Kansas
Conservation Division
200 Colorado Derby Building
Wichita, Kansas 67202
(316) 263-3238