

EL 11845
CARD MUST BE TYPED

State of Kansas
NOTICE OF INTENTION TO DRILL
(see rules on reverse side)

CARD MUST BE SIGNED

Starting Date: 11-21-84
month day year

API Number 15- 163-22,572-0000

OPERATOR: License # 5900
Lawbanco Drilling, Inc.

NE NW NW Sec 19 Twp 7S Rge 17
(location) East West

Name Box 289
Address Natoma, Kansas 67651
City/State/Zip
Contact Person Reva F. Musgrove
Phone 913-885-4676

5080 Ft North from Southeast Corner of Section
4290 Ft West from Southeast Corner of Section
(Note: Locate well on Section Plat on reverse side)

CONTRACTOR: License # 9087
R & C Drilling Co. Inc.
Name Hays, Kansas 67601
City/State

Nearest lease or unit boundary line 195 feet.

County Rooks
Lease Name Lawbanco Well# I-8

Domestic well within 330 feet: yes no

Municipal well within one mile: yes no

Well Drilled For: Well Class: Type Equipment:
 Oil Swd Infield Mud Rotary
 Gas Inj Pool Ext. Air Rotary
 OWWO Expl Wildcat Cable

Depth to Bottom of fresh water 60 feet

Lowest usable water formation Dakota

Depth to Bottom of usable water 725 feet

Surface pipe by Alternate: 1 2

Surface pipe to be set 1200 feet

Conductor pipe if any required 90 feet

Ground surface elevation 1785 feet MSL

This Authorization Expires 5-27-85

Approved By 11-27-84 [Signature]

If OWWO: old well info as follows:

Operator
Well Name
Comp Date Old Total Depth
Projected Total Depth 3500 feet
Projected Formation at TD Arbuckle
Expected Producing Formations Arbuckle


I certify that we will comply with K.S.A. 55-101, et seq., plus eventually plugging hole to K.C.C. specifications.

Date 11-20-84 Signature of Operator or Agent Reva F. Musgrove Title Bookkeeper

**Must be filed with the K.C.C. five (5) days prior to commencing well
This card void if drilling not started within six (6) months of date received by K.C.C.**

Important procedures to follow :

**A Regular Section of Land
1 Mile = 5,280 Ft.**

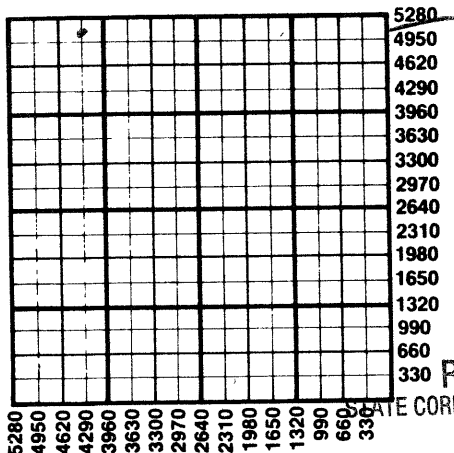

1. Notify District office before setting surface casing.
2. Set surface casing by circulating cement to the top.
3. File completion forms ACO-1 with K.C.C. within 90 days of well completion, following instructions on ACO-1, side 1, and including copies of wireline logs.
4. Notify District office 48 hours prior to old well workover or re-entry.
5. Prior to plugging, prepare a plugging plan, then obtain agreement from the appropriate district office for an approved plugging plan.
6. Submit plugging report (CP-4) to K.C.C. after plugging is completed.
7. Obtain an approved injection docket number before disposing of salt water.
8. Notify K.C.C. within 10 days when injection commences or terminates.
9. If an alternate 2 completion, cement in the production pipe from below any usable water to surface within 120 days of spud date.

RECEIVED
STATE CORPORATION COMMISSION
NOV 21 1984

CONSERVATION DIVISION
Wichita, Kansas

State Corporation Commission of Kansas
Conservation Division
200 Colorado Derby Building
Wichita, Kansas 67202
(316) 263-3238