

This form shall be filed in duplicate with the Kansas Corporation Commission, 200 Colorado Derby Building, Wichita, Kansas 67202, within ten days after the completion of the well, regardless of how the well was completed.

Attach separate letter of request if the information is to be held confidential. If confidential, only file one copy. Information on side one will be of public record and side two will then be held confidential.

Circle one: Oil, Gas, Dry, SWD, OWWO, Injection. Type and complete ALL sections. Applications must be filed for dual completion, commingling, SWD and injection, T.A.

Attach wireline logs (i.e. electrical log, sonic log, gamma ray neutron log, etc.). KCC # (316) 263-3238. (Rules 82-2-105 & 82-2-125)

OPERATOR C. C. & S. Oil Operations, Inc.

API NO. 15-163,21,667-0000

ADDRESS 12 Northridge Plaza
Hays, Ks. 67601

COUNTY Rooks

FIELD Riffe

**CONTACT PERSON Dan Schippers
PHONE (913) 628-3284

PROD. FORMATION Arbuckle

PURCHASER CRA, Inc.

LEASE F. Walker 'B'

ADDRESS P. O. Box 7305
Kansas City, Mo. 64116

WELL NO. 3

WELL LOCATION NW-SE-NE

DRILLING Lawbanco Drilling, Inc.

3630 Ft. from S Line and

CONTRACTOR ADDRESS P. O. Box 289


990 Ft. from E Line of

Natoma, Ks. 67651

the NE/4 SEC. 19 TWP. 7S RGE. 17W

PLUGGING CONTRACTOR ADDRESS

WELL PLAT

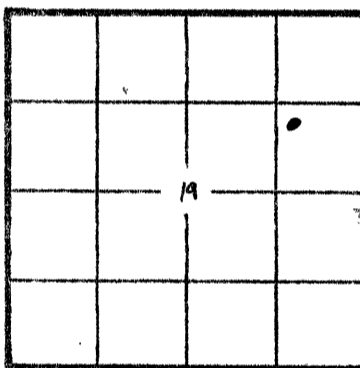

KCC
KGS
(Office Use)

JUN 15 1982
6-15-82
CONSERVATION DIVISION
Wichita, Kansas

TOTAL DEPTH 3215 PBT

SPUD DATE 5/04/82 DATE COMPLETED 5/11/82

ELEV: GR 1740' DF 1743' KB 1745'

DRILLED WITH (CABLE) (ROTARY) (AIR) TOOLS

Amount of surface pipe set and cemented 1176' DV Tool Used? NO

AFFIDAVIT

STATE OF Kansas, COUNTY OF Ellis SS, I,

Daniel F. Schippers OF LAWFUL AGE, BEING FIRST DULY SWORN UPON HIS OATH,

DEPOSES THAT HE IS Controller (FOR)(OF) C. C. & S. Oil Operations, Inc.

OPERATOR OF THE F. Walker 'B' LEASE, AND IS DULY AUTHORIZED TO MAKE

THIS AFFIDAVIT FOR AND ON THE BEHALF OF SAID OPERATOR, THAT WELL NO. 3 ON

SAID LEASE HAS BEEN COMPLETED AS OF THE 3rd DAY OF June, 19 82, AND THAT

ALL INFORMATION ENTERED HEREIN WITH RESPECT TO SAID WELL IS TRUE AND CORRECT.


FURTHER AFFIANT SAITH NOT.

SUBSCRIBED AND SWORN BEFORE ME THIS 14th DAY OF June, 19 82.

(S) Daniel F. Schippers

Robin K. McDowell

MY COMMISSION EXPIRES:

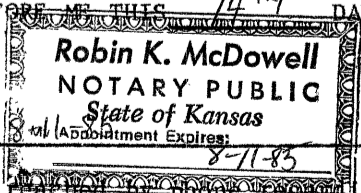

NOTARY PUBLIC, Robin K. McDowell

**The person who can be reached by phone regarding any questions concerning this information. Within 45 days of completion, a witnessed initial test by the Commission is required if the well produces more than 25 BOPD or is located in a Basic Order Pool.

WELL LOG

Show all important zones of porosity and contents thereof; cored intervals, and all drill-stem tests, including depth interval tested, cushion used, time tool open, flowing and shut-in pressures, and recoveries.

SHOW GEOLOGICAL MARKERS, LOGS RUN, OR OTHER DESCRIPTIVE INFORMATION.

FORMATION DESCRIPTION, CONTENTS, ETC.	TOP	BOTTOM	NAME	DEPTH
Anhydrite	1168	1176		
Base Anhydrite	1204	1216		
Topeka	2668	2669		
Queen Hill Sd.	2817	2818		
Heebner	2876	2877		
Toronto	2901	2901		
Lansing-K.C.	2920	2922		
Base K.C.	3155	3156		
Marmaton Lm.	3180	3183		
Arbuckle	3211	3212		
T.D.	3215	3216		

Report of all strings set— surface, intermediate, production, etc. CASING RECORD (New) or (Used)

Purpose of string	Size hole drilled	Size casing set (in O.D.)	Weight lbs/ft.	Setting depth	Type cement	Sacks	Type and percent additives
Conductor	17 1/4"	13 3/8"	48	95'	common	120	3% cc 2% gel
Surface	12 1/4"	8 5/8"	24	1176'	common	450	3% cc 2% gel ASC
Production	7 7/8"	5 1/2"	14	3215'	AST	150	ASC

LINER RECORD

PERFORATION RECORD

Top, ft.	Bottom, ft.	Sacks cement	Shots per ft.	Size & type	Depth interval

TUBING RECORD

Size	Setting depth	Packer set at	(open hole completion)
2 7/8"	3229.41	--	

ACID, FRACTURE, SHOT, CEMENT SQUEEZE RECORD

Amount and kind of material used	Depth interval treated
NONE	NONE

Date of first production	6/02/82	Producing method (flowing, pumping, gas lift, etc.)	Pumping	Gravity	25°
RATE OF PRODUCTION PER 24 HOURS	Oil 50 bbls.	Gas 0 MCF	Water 0 %	Gas-oil ratio	CFPB
Disposition of gas (vented, used on lease or sold)			Perforations	NONE	NONE