

STATE OF KANSAS
STATE CORPORATION COMMISSION

15-163-21800-00-00

WELL PLUGGING RECORD

Give All Information Completely
Make Required Affidavit
Mail or Deliver Report to
Conservation Division
State Corporation Comm.
245 North Water
Wichita, KS 67202

Rooks County. Sec. 13 Twp. 7S Rge. 18W E/W
Location as "NE/CNW $\frac{1}{4}$ SW $\frac{1}{4}$ " or footage from lines
NW NW NE

Lease Owner A. & M. Oil Inc.

Lease Name Conn Well No. 1

Office Address P.O. Box 272 Stockton, Kansas 67669

Character of Well (Completed as Oil, Gas or Dry Hole)
dry hole

Date Well completed 9-20-82 19

Application for plugging filed 9-20-82 19

Application for plugging approved 9-20-82 19

Plugging commenced 7:10 P.M. 9-20-82 19

Plugging completed 8:30 P.M. 9-20-82 19

Reason for abandonment of well or producing formation
dry


If a producing well is abandoned, date of last production
19

Was permission obtained from the Conservation Division or
its agents before plugging was commenced? yes

Name of Conservation Agent who supervised plugging of this well Marion Schmidt

Producing formation _____ Depth to top _____ Bottom _____ Total Depth of Well _____

Show depth and thickness of all water, oil and gas formations.

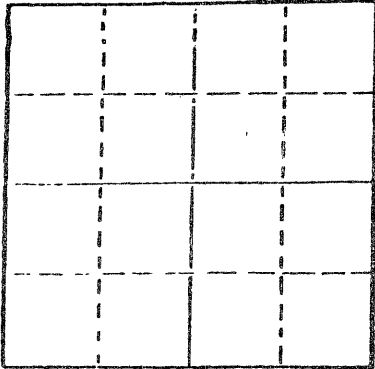

Locate well correctly on above
Section Plat

OIL, GAS OR WATER RECORDS

CASING RECORD

FORMATION	CONTENT	FROM	TO	SIZE	PUT IN	PULLED OUT

Describe in detail the manner in which the well was plugged, indicating where the mud fluid was placed and the method or methods used in introducing it into the hold. If cement or other plugs were used, state the character of same and depth placed, from _____ feet to _____ feet for each plug set.

- 1st plug at 780' with 100 sacks
- 2nd plug at 270' with 40 sacks
- 3rd plug at 40' with 10 sacks
- 1 sack hulls and plug for solid bridge
- Plugged rat hole with 10 sacks
- Total 160 sacks 50/50 poz 6% gel, 3% cc

RECEIVED
STATE CORPORATION COMMISSION
SEP 29 1982
CONSERVATION DIVISION
Wichita, Kansas
9-28-82

(If additional description is necessary, use BACK of this sheet)

Name of Plugging Contractor Lawbanco Drilling, Inc.
Box 289 Natoma, Kansas 67651

STATE OF Kansas COUNTY OF Osborne, ss.
John Weis (employee of owner) or (owner or operator)

of the above-described well, being first duly sworn on oath, says: That I have knowledge of the facts, statements, and matters herein contained and the log of the above-described well as filed and that the same are true and correct. So help me God.

(Signature) John Weis
Countryside Est. 17-B Hays, Ks 67669
(Address)

SUBSCRIBED AND SWORN TO before me this 27th day of Sept., 1982

Ethel A. Johns
Notary Public.

My commission expires 12-2-85

