


STATE OF KANSAS  
 STATE CORPORATION COMMISSION  
 200 Colorado Derby Bldg.  
 Wichita, Kansas 67202

Form CP-4  
 Rev. 12-15-80

WELL PLUGGING RECORD 15-163-21760-00-00

Give All Information Completely  
 Make Required Affidavit

COUNTY Rooks SEC. 35 TWP. 7S RGE. 17  W  
 Location as in quarters or footage from lines:  
SE NW SE

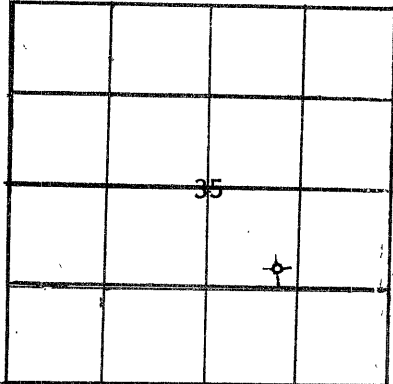

Locate Well  
 correctly on above  
 Section Platt.

Lease Owner Harold Krueger Company  
 Lease Name Maxwell Well No. 3  
 Office Address Box 247, Natoma, KS 67651  
 Character of Well (Completed as Oil, Gas or Dry Hole): D&A  
 Date Well Completed September 24, 1982  
 Application for plugging filed September 23, 1982  
 Plugging commenced September 24, 1982  
 Plugging completed September 24, 1982  
 Reason for abandonment of well or producing formation D & A

Was permission obtained from the Conservation Division or it's  
 Agent's before plugging was commenced? Yes

Name of Conservation Agent who supervised plugging of this well Dennis Hemel

Producing formation n/a Depth to top n/a bottom n/a T.D. 3225'

Show depth and thickness of all water, oil and gas formations.

OIL, GAS OR WATER RECORDS

Casing Record

Formation	Content	From	To	Size	Put in	Pulled Out
				8-5/8"	252.63'	-0-

Describe in detail the manner in which the well was plugged, indicating where the mud  
 fluid was placed and the method or methods used in introducing it into the hold. If cement  
 or other plugs were used, state the character of same and depth placed, from \_\_\_\_\_ feet  
 to \_\_\_\_\_ feet for each plug set.

Hole Plugged

1st @ 800' w/100 sx

2nd @ 270' w/40 sx

bridge plug @ 40' to surface w/10 sx

10 sx in rathole

Cmt. w/160 sx 50-50 poz, 6% Gel

(If additional description is necessary, use BACK of this sheet)

Name of Plugging Contractor Allied Cementing Company  
Box 31, 332 W. Wichita, KS 67665

STATE OF KANSAS COUNTY OF OSBORNE, ss.

Dean Wineland (employee of owner) or (owner or operator) of the  
 above-described well, being first duly sworn on oath, says: That I have knowledge of the  
 facts, statements, and matters herein contained and the log of the above-described well as  
 filed and that the same are true and correct. So help me God.

RECEIVED  
 SEP 30 1982

CONSERVATION DIVISION  
 Wichita, Kansas

(Signature) Dean Wineland  
Natoma, Kansas 67651  
 (Address)

SUBSCRIBED AND SWORN TO before me this 29<sup>th</sup> day of September 19 82

Della M. Richmond  
 Notary Public.

My Commission expires: 7-12-84

DELLA M. RICHMOND  
 STATE NOTARY PUBLIC  
 OSBORNE COUNTY, KANSAS  
 My Appt. Exp. \_\_\_\_\_