

STATE OF KANSAS
STATE CORPORATION COMMISSION

Give All Information Completely
Make Required Affidavit
Mail or Deliver Report to:


Conservation Division
State Corporation Commission
800 Bittling Building
Wichita, Kansas

15-163-03446-00-00
WELL PLUGGING RECORD

OR
FORMATION PLUGGING RECORD

Strike out upper line
when reporting plug-
ging off formations.

NORTH

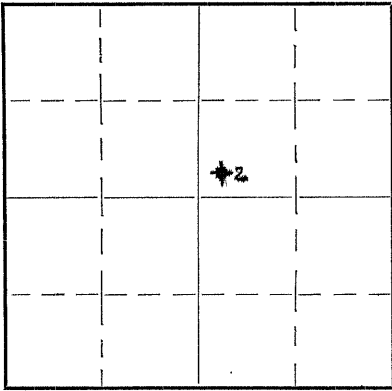

Locate well correctly on above
Section Plat

Rooks _____ County. Sec. 35 Twp. 7S Rge. 17W (E) _____ (W)
Location as "NE $\frac{1}{4}$ NW $\frac{1}{4}$ SW $\frac{1}{4}$ " or footage from lines _____ SW SW NE
Lease Owner _____ Alkay Oil Company
Lease Name _____ Hindman _____ Well No. 2
Office Address _____ 929 Kennedy Building - Tulsa, Oklahoma
Character of Well (Completed as Oil, Gas or Dry Hole) _____ Dry Hole
Date, well completed _____ October 17 1947
Application for plugging filed _____ October 18 1947
Application for plugging approved _____ October 18 1947
Plugging Commenced _____ October 18 1947
Plugging Completed _____ October 18 1947
Reason for abandonment of well or producing formation _____ Dry Hole

If a producing well is abandoned, date of last production _____ 193____
Was permission obtained from the Conservation Division or its agents before plugging was com-
menced? _____ Yes

Name of Conservation Agent who supervised plugging of this well _____ C. D. Stough
Producing formation _____ Depth to top _____ Bottom _____ Total Depth of Well _____ 3357 Feet.
Show depth and thickness of all water, oil and gas formations.

OIL, GAS OR WATER RECORDS

CASING RECORD

Formation	Content	From	To	Size	Put In	Pulled Out
Topeka Lime	Show of Oil & Water	2764	2984	8 5/8	350	None
Kansas City Lime	Show of Oil & Water	3016	3269			

Describe in detail the manner in which the well was plugged, indicating where the mud fluid was placed and the method or methods used in introducing it into the hole. If cement or other plugs were used, state the character of same and depth placed, from _____ feet to _____ feet for each plug set.

3357 TD
3357 - 350 Heavy Mud
350 - 300 Plug and Cement
300 - 30 Heavy Mud
30 - 0 Plug and Cement

(If additional description is necessary, use BACK of this sheet)

Correspondence regarding this well should be addressed to _____ Alkay Oil Company
Address _____ 929 Kennedy Building - Tulsa, Oklahoma

10-24-47

STATE OF OKLAHOMA, COUNTY OF TULSA, ss.

Frank O. Bennett (employee of owner) or ~~owner or operator~~ of the above-described well, being first duly sworn on oath, says: That I have knowledge of the facts, statements, and matters herein contained and the log of the above-described well as filed and that the same are true and correct. So help me God.

(Signature) Frank O. Bennett

929 Kennedy Building - Tulsa, Oklahoma
(Address)

SUBSCRIBED AND SWORN TO before me this 23 day of October, 1947

My commission expires Dec. 13, 1947

W. Otis Smith
Notary Public.

17-6058 10-38-5M

