


STATE OF KANSAS
STATE CORPORATION COMMISSION

15-163-0319a-00-00
WELL PLUGGING RECORD

Give All Information Completely
Make Required Affidavit
Mail or Deliver Report to:
Conservation Division
State Corporation Commission
800 Bitting Building
Wichita, Kansas

Rooks County. Sec. 35 Twp. 7 Rge. (E) 17 (W)
Location as "NE/CNW $\frac{1}{4}$ SW $\frac{1}{4}$ " or footage from lines C NW NW
Lease Owner Cooperative Refinery Association
Lease Name Kelly Well No. 1
Office Address Great Bend, Kansas
Character of Well (completed as Oil, Gas or Dry Hole) Oil
Date well completed September 17 19 43
Application for plugging filed January 22 19 52
Application for plugging approved January 23 19 52
Plugging commenced January 24 19 52
Plugging completed February 1 19 52
Reason for abandonment of well or producing formation Depleted Production
If a producing well is abandoned, date of last production 19
Was permission obtained from the Conservation Division or its agents before plugging was commenced? Yes

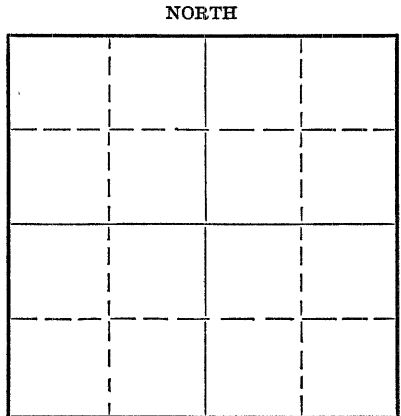

Locate well correctly on above Section Plat

Name of Conservation Agent who supervised plugging of this well Eldon Patty
Producing formation Lansing-Kansas City Depth to top 3045 Bottom 3106 Total Depth of Well 3106 Feet
Show depth and thickness of all water, oil and gas formations.

OIL, GAS OR WATER RECORDS

CASING RECORD

Formation	Content	From	To	Size	Put In	Pulled Out
Lansing-Kansas City	Oil	3045	3106	8 5/8 5 1/2"	106' 3072'	None 1800'

Describe in detail the manner in which the well was plugged, indicating where the mud fluid was placed and the method or methods used in introducing it into the hole. If cement or other plugs were used, state the character of same and depth placed, from _____ feet to _____ feet for each plug set.

Filled with chat From 3106 to 3086
Cement 4 sacks From 3086 to 3056
Mudded From 3056 to 275
Rockbridge From 275 to 250
Cement 15 sacks From 250 to 205
Mudded From 205 to 40
Rock bridge From 40 to 30
Cement 10 sacks From 30 to Bottom of cellar
Filled cellar to surface

(If additional description is necessary, use BACK of this sheet)

Correspondence regarding this well should be addressed to Cooperative Refinery Association
Address Box 765 Great Bend, Kansas

STATE OF Kansas, COUNTY OF Barton, ss.
L. M. Collins (employee of owner) or (owner or operator) of the above-described well,

being first duly sworn on oath, says: That I have knowledge of the facts, statements, and matters herein contained and the log of the above-described well as filed and that the same are true and correct. So help me God.

(Signature) L M Collins
Great Bend, Kansas (Address)

SUBSCRIBED AND SWORN TO before me this 7th day of February, 19 52.

My commission expires February 14, 1955 Notary Public.

PLUGGING
FILE SEC 35 T 7 R 17
BOOK PAGE 139 OF 33

28-5091-S 8-50-10M

FEB 8 X 1952 2-8-52