

STATE OF KANSAS
STATE CORPORATION COMMISSION

15-163-20975-00-00

WELL PLUGGING RECORD

Give All Information Completely
Make Required Affidavit
Mail or Deliver Report to
Conservation Division
State Corporation Comm.
245 North Water
Wichita, KS 67202

Rooks County, Sec. 7 Twp. 7 Rge. 18 E/W
Location as "NE/CNW¹/SW¹" or footage from lines
NE NE NW


Lease Owner Chenco, Inc.
Lease Name Bedker #1 Well No. _____
Office Address Plainville, Kansas 67663
Character of Well (Completed as Oil, Gas or Dry Hole) _____

Date Well completed _____ 19____
Application for plugging filed _____ 19____
Application for plugging approved _____ 19____
Plugging commenced 3/25/80 _____ 19____
Plugging completed 3/27/80 _____ 19____
Reason for abandonment of well or producing formation
depleted

If a producing well is abandoned, date of last production _____ 19____

Was permission obtained from the Conservation Division or its agents before plugging was commenced? yes

Name of Conservation Agent who supervised plugging of this well Balthazor
Producing formation _____ Depth to top _____ Bottom _____ Total Depth of Well 3555
Show depth and thickness of all water, oil and gas formations.

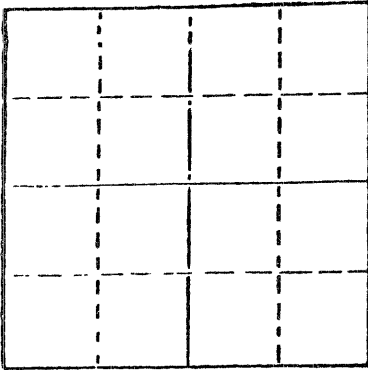

Locate well correctly on above Section Plat

OIL, GAS OR WATER RECORDS

CASING RECORD

FORMATION	CONTENT	FROM	TO	SIZE	PUT IN	PULLED OUT
				8-5/8	201	none
				4 1/2"	3486	2632'

Describe in detail the manner in which the well was plugged, indicating where the mud fluid was placed and the method or methods used in introducing it into the hold. If cement or other plugs were used, state the character of same and depth placed, from _____ feet to _____ feet for each plug set.

Pulled 66 joints of 4 1/2" casing. Plugged well with 3 sacks hulls, 12 sacks gel, 65 sacks cement, 6 sacks gel, 2 sacks hulls, 8-5/8 plug, 70 sacks cement, 50-50 with 6%.

PLUGGING COMPLETE.

(If additional description is necessary, use BACK of this sheet)

Name of Plugging Contractor KELSO CASING PULLING CHASE, KANSAS

STATE OF KANSAS COUNTY OF RICE
R. DARRELL KELSO (employee of owner) or (owner or operator)
of the above-described well, being first duly sworn on oath, says: That I have knowledge of the facts, statements, and matters herein contained and the log of the above-described well as filed and that the same are true and correct. So help me God.

(Signature) R. Darrell Kelso
CHASE, KANSAS

(Address)

SUBSCRIBED AND SWORN TO before me this 31st day of March, 1980

Margaret Melcher
Notary Public.

My commission expires _____



STATE RECEIVED
APR - 1 1980
CONSERVATION DIVISION
STATE CORPORATION COMMISSION
4-1-80

