

15-163-02664-00-00  
WELL PLUGGING RECORD

STATE OF KANSAS  
STATE CORPORATION COMMISSION

OR  
FORMATION PLUGGING RECORD

Strike out upper line  
when reporting plug-  
ging off formations.

Give All Information Completely  
Make Required Affidavit  
Mail or Deliver Report to:  
Conservation Division  
State Corporation Commission  
800 Bittig Building  
Wichita, Kansas

Rocks

County. Sec. 10 Twp. 7 Rge. 18W (E) (W)

Location as "NE 1/4 NW 1/4 SW 1/4" or footage from lines C SW 1/2 SW 1/2

Lease Owner The Carter Oil Company

Lease Name E. K. Bigge Well No. 1

Office Address Box 786, Great Bend, Kansas

Character of Well (completed as Oil, Gas or Dry Hole) Dry Hole

Date well completed 6-18-43

Application for plugging filed 19

Application for plugging approved 19


Plugging commenced 6-18-43 19

Plugging completed 6-18-43 19

Reason for abandonment of well or producing formation Dry Hole

If a producing well is abandoned, date of last production 19

Was permission obtained from the Conservation Division or its agents before plugging was com-  
menced? Yes

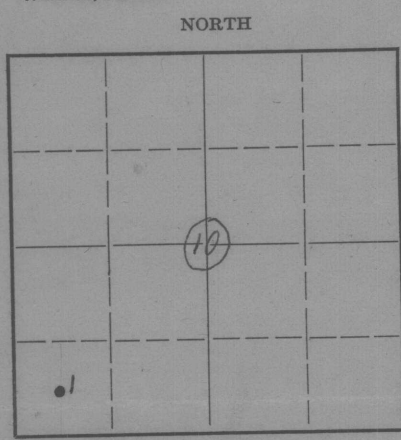

Locate well correctly on above  
Section Plat

Name of Conservation Agent who supervised plugging of this well Burt Stafford

Producing formation None Depth to top Bottom Total Depth of Well 3591 Feet

Show depth and thickness of all water, oil and gas formations.

OIL, GAS OR WATER RECORDS


CASING RECORD

Formation	Content	From	To	Size	Put In	Pulled Out
None				10 3/4	267	None
				8 5/8	1277	None

Describe in detail the manner in which the well was plugged, indicating where the mud fluid was placed and the method or methods used in introducing it into the hold. If cement or other plugs were used, state the character of same and depth placed, from feet to feet for each plug set.

Mud 3591 - 1250'  
 Cement 1250 - 1190'  
 Mud 1190 - 260'  
 Cement 260 - 230'  
 Mud 230 - 30'  
 Cement 30 - 6'  
 Soil 6 - 0'

PLUGGING  
 FILE 10 7-18W  
 BOOK PAGE 79 LINE 36

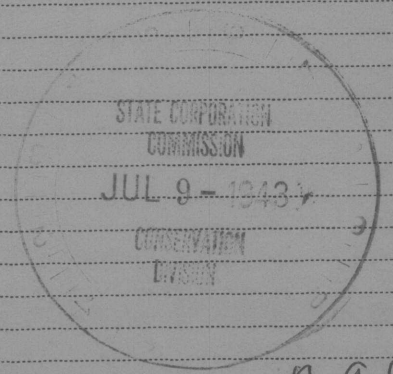

(If additional description is necessary, use BACK of this sheet)

Correspondence regarding this well should be addressed to E. A. Rose  
Address Box 786, Great Bend, Kansas

7-9-43

STATE OF Kansas, COUNTY OF Barton, ss.

A. E. Brink (employee of owner) or (owner or operator) of the above-described well,  
being first duly sworn on oath, says: That I have knowledge of the facts, statements, and matters herein contained and the log of the above-  
described well as filed and that the same are true and correct. So help me God.

(Signature) A. E. Brink  
Box 786 Great Bend, Kans.  
(Address)

SUBSCRIBED AND SWORN to before me this 8th day of July, 1943

M. Gardner  
Notary Public.

My commission expires July 29, 1946

