

This form shall be filed in duplicate with the Kansas Corporation Commission, 200 Colorado Derby Building, Wichita, Kansas 67202, within ten days after the completion of the well, regardless of how the well was completed.

Attach separate letter of request if the information is to be held confidential. If confidential, only file one copy. Information on side one will be of public record and side two will then be held confidential.

Circle one: Oil Gas, Dry, SWD, OWWO, Injection. Type and complete ALL sections. Applications must be filed for dual completion, commingling, SWD and injection, T.A.

Attach wireline logs (i.e. electrical log, sonic log, gamma ray neutron log, etc.). KCC # (316) 263-3238. (Rules 82-2-105 & 82-2-125)

Thomas E. Black d/b/a OPERATOR BLACK PETROLEUM COMPANY

API NO. 15-163,21,503 -00-00

ADDRESS Suite 545 O.W. Garvey Bldg. 200 W. Douglas, Wichita, Ks.

COUNTY Rooks

FIELD ? STOCKTON

**CONTACT PERSON Thomas E. Black PHONE 316-264-9342

PROD. FORMATION Lansing-K.C.

LEASE Simons

PURCHASER Koch Oil Company

WELL NO. 1

ADDRESS Box 2256 Wichita, Ks. 67201

WELL LOCATION SE NE SW

330 Ft. from East Line and


990 Ft. from North Line of

the SW/4 SEC. 35 TWP. 7S RGE. 17W

DRILLING Shields Drilling Co. CONTRACTOR ADDRESS Shields Bldg. Box 709

Russell, Ks. 67665

WELL PLAT

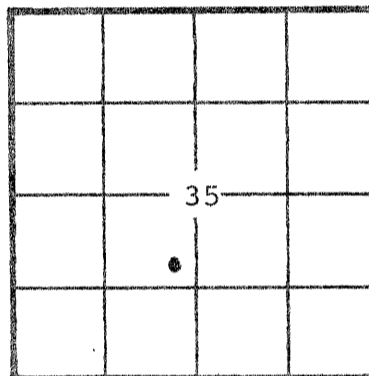

KCC [check] KGS [check] (Office Use)

PLUGGING CONTRACTOR ADDRESS

TOTAL DEPTH 3425 PBSD 3268

SPUD DATE 11/24/81 DATE COMPLETED 12/28/81

ELEV: GR 1932 DF 1935 KB 1937

DRILLED WITH (CABLE) ROTARY (AIR) TOOLS

Amount of surface pipe set and cemented 250' 8 5/8" 165 SX. DV Tool Used? No


AFFIDAVIT

STATE OF Kansas, COUNTY OF Sedgwick SS, I, Thomas E. Black OF LAWFUL AGE, BEING FIRST DULY SWORN UPON HIS OATH,

DEPOSES THAT HE IS owner (FOR)(OF) Black Petroleum Company OPERATOR OF THE Simons LEASE, AND IS DULY AUTHORIZED TO MAKE

THIS AFFIDAVIT FOR AND ON THE BEHALF OF SAID OPERATOR, THAT WELL NO. 1 ON SAID LEASE HAS BEEN COMPLETED AS OF THE 4th DAY OF Jan., 19 82, AND THAT ALL INFORMATION ENTERED HEREIN WITH RESPECT TO SAID WELL IS TRUE AND CORRECT.

FURTHER AFFIANT SAITH NOT

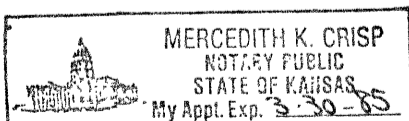

(S) Thomas E. Black

SUBSCRIBED AND SWORN BEFORE ME THIS 4th DAY OF January, 19 82.

Mercedith K. Crisp NOTARY PUBLIC Mercedith K. Crisp

MY COMMISSION EXPIRES: March 30, 1985.

**The person who can be reached by phone regarding any questions concerning this information. Within 45 days of completion, a witnessed initial test by the Commission is required if the well produces more than 25 BOPD or is located in a Basic Order Pool.

01-04-82