


15-163-21755-00-00

WELL PLUGGING RECORD

Give All Information Completely
Make Required Affidavit
Mail or Deliver Report to
Conservation Division
State Corporation Comm.
200 Colorado Derby Bldg.
202 W. 1st St.
Wichita, KS 67202

Rooks County Sec. 24 Twp. 7s Rge. 18 ~~XX~~ W.
Location as "NE/CNW/SW" or footage from lines
330' FSL 400' From West half of Block 39 in Woods addition
to the City Of Stockton.
Lease Owner Liberty Enterprises, Inc.
Lease Name John Deere Well No. #1
Office Address 308 West Mill Plainville, Ks 67663
Character of Well (Completed as Oil, Gas or Dry Hole) Dry Hole

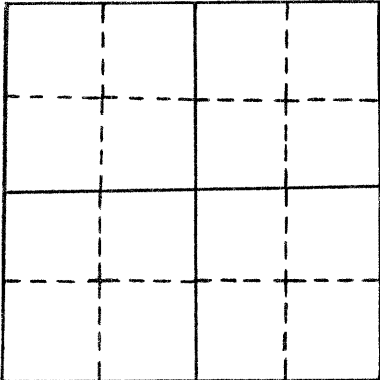

locate well correctly
on above
Section Plot

Date Well completed 10-25 1982
Application for plugging filed 10-25 1982
Application for plugging approved 10-25 1982
Plugging commenced 4:30 P.M. 10-25 1982
Plugging completed 9:00 P.M. 10-25 1982
Reason for abandonment of well or producing formation No Commercial Production

If a producing well is abandoned, date of last production 19

Was permission obtained from the Conservation Division or its agents before plugging was commenced? Yes

Name of Conservation Agent who supervised plugging of this well Marion Schmidt
Producing formation Depth to top Bottom Tl. Depth of Well
Show depth and thickness of all water, oil and gas formations.

OIL, GAS OR WATER RECORDS

CASING RECORD

FORMATION	CONTENT	FROM	TO	SIZE	PUT IN	PULLED OUT
Surface Casing	60-40poz & common	0'	1209'	8 5/8"	1209'	0'

Describe in detail the manner in which the well was plugged, indicating where the mud fluid was placed and the method or methods used in introducing it into the hold. If cement or other plugs were used, state the character of same and depth placed, from feet to feet for each plug set.

Plug #1 3230' with 20sxs

Plug #2 1230' with 20sxs

Plug #3 600' with 100sxs

Plug #4 40' with 10sxs

10sxs in rathole

Total 160sxs 50-50poz 6%gel 3%cc


P.D. @ 9:00 P.M. 10-25-82

(If additional description is necessary, use BACK of this sheet)

Name of Plugging Contractor PIONEER DRILLING COMPANY
308 West Mill Plainville, Ks 67663

STATE OF KANSAS COUNTY OF Rooks, ss.

David L. Comeau (employee of owner) or (owner or operator) of the above described well, being first sworn on oath, says: That I have knowledge of the facts, statements, and matters herein and the log of the above described well is filed and that the same are true and correct. So help me God.

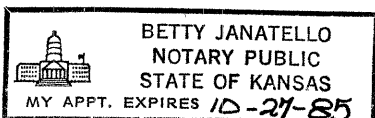

NOV 1 1982
RECEIVED
STATE CORPORATION COMMISSION
Wichita, Kansas
CONSERVATION DIVISION

Signature of David L. Comeau
(Address) 308 West Mill Plainville, Ks 67663

SUBSCRIBED AND SWORN TO before me this 28th day of October, 1982

My commission expires 10-27-85

Signature of Betty Janatello
Notary Public