


15-163-00355-00-00

WELL PLUGGING RECORD

Give All Information Completely
Make Required Affidavit
Mail or Deliver Report to:
Conservation Division
State Corporation Commission
800 Bitting Building
Wichita, Kansas

NORTH

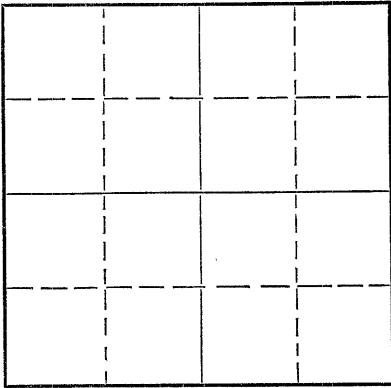

Locate well correctly on above
Section Plat

Rooks County. Sec. 23 Twp. 7S Rge. 18 (E) W. (W)
Location as "NE/CNW $\frac{1}{4}$ SW $\frac{1}{4}$ " or footage from lines NE/C SE/4 NW/4
Lease Owner Harry Koplin
Lease Name Tatman Well No. 1
Office Address 153 West Huron Street, Chicago 10, Illinois
Character of Well (completed as Oil, Gas or Dry Hole) Dry Hole
Date well completed July 13 19 52
Application for plugging filed July 12 19 52
Application for plugging approved July 12 19 52
Plugging commenced July 13 19 52
Plugging completed July 14 19 52
Reason for abandonment of well or producing formation Dry hole

If a producing well is abandoned, date of last production _____ 19____
Was permission obtained from the Conservation Division or its agents before plugging was commenced? Yes

Name of Conservation Agent who supervised plugging of this well Elden Petty
Producing formation Arbuckle Depth to top _____ Bottom _____ Total Depth of Well 3335 Feet
Show depth and thickness of all water, oil and gas formations.

OIL, GAS OR WATER RECORDS

CASING RECORD

Formation	Content	From	To	Size	Put In	Pulled Out
				8-5/8"	1,053'	none

Describe in detail the manner in which the well was plugged, indicating where the mud fluid was placed and the method or methods used in introducing it into the hole. If cement or other plugs were used, state the character of same and depth placed, from _____ feet to _____ feet for each plug set.

- Hole was filled to 240' with heavy mud
- Halliburton plug pushed to 240'
- Halliburton pumped in 70 sacks cement from 20' to 240'
- Second plug set at 20'
- 10 sacks cement mixed and hole filled

RECEIVED
STATE CORPORATION COMMISSION
JUL 17 1952
CONSERVATION DIVISION
Wichita, Kansas

(If additional description is necessary, use BACK of this sheet)
Name of Plugging Contractor D. & M Drilling Company, Inc. 7-17-52
Address Box 247, Great Bend, Kansas

STATE OF Kansas, COUNTY OF Barton, ss.
Don S. Packer (employee of owner) or (owner or operator) of the above-described well, being first duly sworn on oath, says: That I have knowledge of the facts, statements, and matters herein contained and the log of the above-described well as filed and that the same are true and correct. So help me God.

(Signature) [Signature]
Box 247, Great Bend, Kansas (Address)

SUBSCRIBED AND SWORN to before me this 16th day of July 19 52
[Signature] Notary Public.

My commission expires September 24, 1955 28-8390-s 6-51-20M

PLUGGING
FILE SEC-23 T 7 R 18
PAGE 30 LINE 31