

CARD MUST BE TYPED

State of Kansas

CARD MUST BE SIGNED

NOTICE OF INTENTION TO DRILL

✓

Expected Spud Date. 10/30/87
month day year

(see rules on reverse side)

API Number 15- 163-22,958-00-00

OPERATOR: License # 4767
Name Ritchie Exploration, Inc.
Address 125 N. Market, Suite 1000
City/State/Zip Wichita, KS 67202
Contact Person Jeff Christian
Phone 316/267-4375

NW SE SW Sec. 6 Twp. 7 S, Rg. 20 XX East West
990 Ft. from South Line of Section
3630 Ft. from East Line of Section

(Note: Locate well on Section Plat on reverse side)

CONTRACTOR: License # 6033
Name Murfin Drilling Co.
City/State Wichita, KS 67202

Nearest lease or unit boundary line 990 feet
County Rooks
Lease Name R.V. Jones Well # 2

Well Drilled For: Well Class: Type Equipment:
 Oil Storage Infield Mud Rotary
 Gas Inj Pool Ext. Air Rotary
 OWWO Expl Wildcat Cable

Ground surface elevation 2202 feet MSL
Domestic well within 330 feet: yes no
Municipal well within one mile: yes no
Depth to bottom of fresh water 100
Depth to bottom of usable water 1200
Surface pipe by Alternate: 1 2
Surface pipe planned to be set 200
Conductor pipe required
Projected Total Depth 3750 feet
Formation Arbuckle

If OWWO: old well info as follows:

Operator
Well Name
Comp Date Old Total Depth

I certify that well will comply with K.S.A. 55-101, et seq., plus eventually plugging ~~not~~ to KCC specifications.

Date Signature of Operator or Agent Jeff Christian Title

For KCC Use:

Conductor Pipe Required _____ feet; Minimum Surface Pipe Required 200 feet per Alt.

This Authorization Expires 4-22-88 Approved By Jeff 10-22-87

EFFECTIVE DATE: 10-27-87


2

Must be filed with the K.C.C. five (5) days prior to commencing well
 This card void if drilling not started within six (6) months of date received by K.C.C.

Important procedures to follow:

1. Notify District office before setting surface casing.
2. Set surface casing by circulating cement to the top.
3. File completion forms ACO-1 with K.C.C. within 120 days of well spud date, following instructions on ACO-1, side 1, and including copies of wireline logs.
4. Notify District office 48 hours prior to old well workover or re-entry.
5. Prior to filing Intent, prepare a proposed plugging plan in case well is D & A, then obtain approval of plan when calling district office prior to setting surface pipe.
6. Submit plugging report (CP-4) to K.C.C. after plugging is completed.
7. Obtain an approved injection docket number before disposing of salt water.
8. Notify K.C.C. within 10 days when injection commences or terminates.
9. If an alternate 2 completion, cement in the production pipe from below any usable water to surface within 120 days of spud date.

A Regular Section of Land
1 Mile = 5,280 Ft.

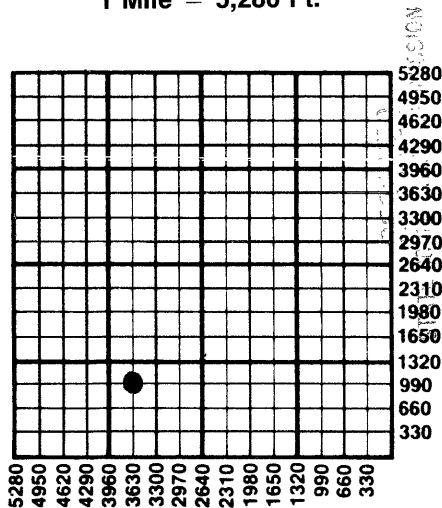

OCT 22 1987

CONSERVATION DIVISION
 Wichita, Kansas

10-22-1987

State Corporation Commission of Kansas
 Conservation Division
 200 Colorado Derby Building
 Wichita, Kansas 67202-1212
 (316) 263-3238