

CARD MUST BE TYPED

State of Kansas  
**NOTICE OF INTENTION TO DRILL**  
(see rules on reverse side)

CARD MUST BE SIGNED

Starting Date: May 16, 1985  
month day year

API Number 15- 163-22,684-00-00

OPERATOR: License # 9747

.SW. SW. NE Sec. 3. Twp 7. S, Rge 18.  East  
(location)  West

Name ..Universal Resources, *Corp*  
Address ..1800 Denver National Bk Plaza  
City/State/Zip ..Denver, CO 80202  
Contact Person ..Dave Putman  
Phone ....303-296-8091

...2970..... Ft North from Southeast Corner of Section  
...2310..... Ft West from Southeast Corner of Section  
(Note: Locate well on Section Plat on reverse side)

CONTRACTOR: License # 9087

Nearest lease or unit boundary line ...330..... feet.  
County ...Rooks.....  
Lease Name ..Bigge..... Well# 1-3.....

Name ....R...&...C...Drilling Co., Inc..  
City/State ..Hays, Kansas.....

Domestic well within 330 feet :  yes  no  
Municipal well within one mile :  yes  no

Well Drilled For: Well Class: Type Equipment:

- |   |                               |   |  |
|---|-------------------------------|---|--|
| <input checked="" type="checkbox"/> Oil | <input type="checkbox"/> Swd  | <input type="checkbox"/> Infield              | <input checked="" type="checkbox"/> Mud Rotary |
| <input type="checkbox"/> Gas            | <input type="checkbox"/> Inj  | <input checked="" type="checkbox"/> Pool Ext. | <input type="checkbox"/> Air Rotary            |
| <input type="checkbox"/> OWWO           | <input type="checkbox"/> Expl | <input type="checkbox"/> Wildcat              | <input type="checkbox"/> Cable                 |

Depth to Bottom of fresh water ....1.00..... feet  
Lowest usable water formation ....*Dakota*.....  
Depth to Bottom of usable water ....9.00..... feet  
Surface pipe by Alternate : 1  2   
Surface pipe to be set .....3.50..... feet  
Conductor pipe if any required ....NA..... feet  
Ground surface elevation ....NA..... feet MSL  
This Authorization Expires .....11-7-85.....  
Approved By .....5-7-85 *Rc*.....

If OWWO: old well info as follows:

Operator .....  
Well Name .....  
Comp Date ..... Old Total Depth .....  
Projected Total Depth .....3540..... feet  
Projected Formation at TD ..3540.....  
Expected Producing Formations ...Arbuckle.....

I certify that we will comply with K.S.A. 55-101, et seq., plus eventually plugging hole to K.C.C. specifications.

Date 5-6-85..... Signature of Operator or Agent

*R. L. Finney*  
R. L. Finney

Title Contractor


Form C-1 4/84

5-7-85

Must be filed with the K.C.C. five (5) days prior to commencing well  
This card void if drilling not started within six (6) months of date received by K.C.C.

**Important procedures to follow:**

**A Regular Section of Land  
1 Mile = 5,280 Ft.**

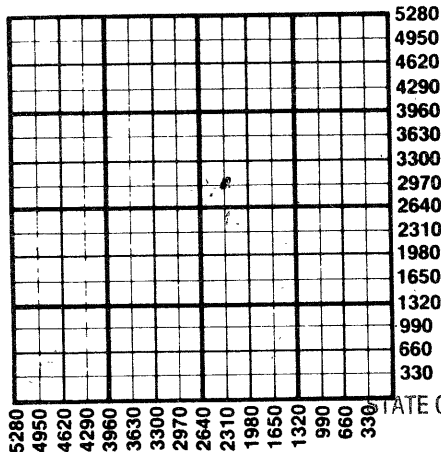

1. Notify District office before setting surface casing.
2. Set surface casing by circulating cement to the top.
3. File completion forms ACO-1 with K.C.C. within 90 days of well completion, following instructions on ACO-1, side 1, and including copies of wireline logs.
4. Notify District office 48 hours prior to old well workover or re-entry.
5. Prior to plugging, prepare a plugging plan, then obtain agreement from the appropriate district office for an approved plugging plan.
6. Submit plugging report (CP-4) to K.C.C. after plugging is completed.
7. Obtain an approved injection docket number before disposing of salt water.
8. Notify K.C.C. within 10 days when injection commences or terminates.
9. If an alternate 2 completion, cement in the production pipe from below any usable water to surface within 120 days of spud date.

RECEIVED

STATE CORPORATION COMMISSION

MAY 07 1985  
5-7-85  
CONSERVATION DIVISION  
Wichita, Kansas

State Corporation Commission of Kansas  
Conservation Division  
200 Colorado Derby Building  
Wichita, Kansas 67202  
(316) 263-3238